

**MISSISSIPPI  
BOARD OF WATER COMMISSIONERS**  
416 North State Street  
Jackson, Mississippi 39201

**WATER WELL DRILLERS LOG**

Hancock  
K2150  
2-67

2-2 1967 SUTTER Well Works Hancock  
date well completed firm name county well located

LANDOWNER: VICTOR LEMAY  
3018 ANNUNCIATION  
NEW ORLEANS LA.  
(mailing address)

description of formations encountered	from	to
	<u>Clay</u>	<u>0</u>
<u>sand</u>	<u>13</u>	<u>25</u>
<u>Clay</u>	<u>25</u>	<u>84</u>
<u>Sand</u>	<u>84</u>	<u>111</u>


WELL LOCATION:  
sec 29 T 8 S R 14 E W  
4 miles NW of Waveland  
(distance) (direction) (nearest town)

WELL PURPOSE: Home  
(home, irrigation, municipal, industrial)

**WELL COMPLETION DATA:**

- (1) diameter (inches) 2
- (2) total depth (feet) 111
- (3) static water level (feet) 1 below above top of ground.
- (4) casing GALV. 105'  
(material) (depth)  
(size) If telescope see back.
- (5) screen 5' 105'  
(length) (depth to top)  
2" SS STAINLESS STEEL  
(size) (material)
- (6) pump Unknown  
(HP) (yield gpm)  
(type power)
- (7) electric log No  
(yes or no)  
(organization running log)
- (8) how well bottom plugged BP VALVE

DRILLERS REMARKS:

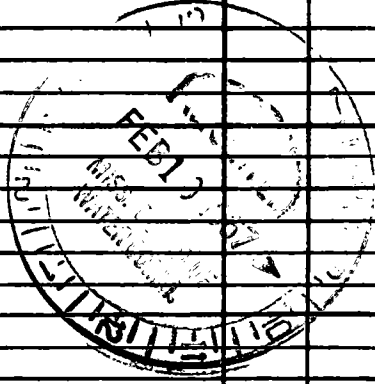

If well telescopes please sketch and show depths.

GROUND LEVEL



	X		

SECTION 29

Please indicate well location X.

ADDITIONAL INFORMATION

If more than one screen, show locations of each on sketch.