

MISSISSIPPI
BOARD OF WATER COMMISSIONERS
416 North State Street
Jackson, Mississippi 39201

WATER WELL DRILLERS LOG

Hancock
K 2181
3-67

3-8 19 67 SUTTER Well Works Hancock
 date well completed firm name county well located

LANDOWNER: ROBT. TURNER

SHORELINE PARK

BAY ST. LOUIS, MISS.
(mailing address)

WELL LOCATION:

sec. 34 T. 8 S. R. 14 W.
2 miles N of Waveland
 (distance) (direction) (nearest town)

WELL PURPOSE: home
 (home, irrigation, municipal, industrial)


WELL COMPLETION DATA:

- (1) diameter (inches) 2
- (2) total depth (feet) 152
- (3) static water level (feet) 5 below above top of ground.
- (4) casing galv. 147'
 (material) (depth)
 (size) If telescope see back.
- (5) screen 5' 147'
 (length) (depth to top)
2" STAINLESS STEEL
 (size) (material)
- (6) pump unknown
 (HP) (yield gpm)
 (type power)
- (7) electric log No
 (yes or no)
 (organization running log)
- (8) how well bottom plugged BPU valve

description of formations encountered

from to


Clay	0	16
sand	16	28
Clay	28	57
sand	57	95
Clay	95	131
Gravel	131	152

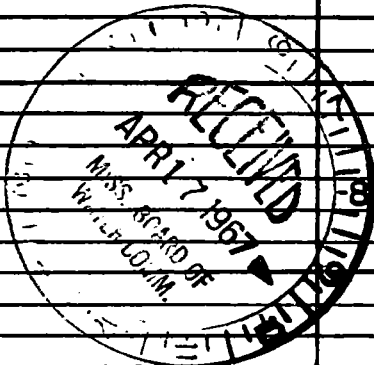

DRILLERS REMARKS:

If well telescopes please sketch and show depths.

GROUND LEVEL

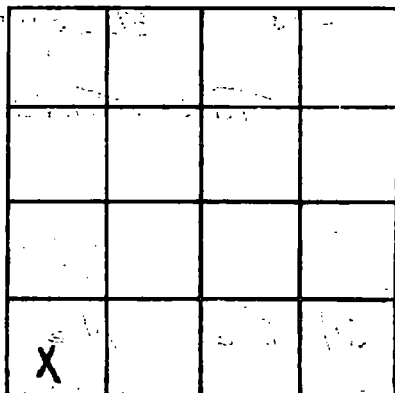

SECTION 34

Please indicate well location X.

ADDITIONAL INFORMATION

If more than one screen, show locations of each on sketch.