

Hancock  
K 2152  
3-67

MISSISSIPPI  
BOARD OF WATER COMMISSIONERS  
416 North State Street  
Jackson, Mississippi 39201

WATER WELL DRILLERS LOG

3-8 1967 Penlon Well Serv Hancock  
date well completed firm name county well located

LANDOWNER: Walter Tadlock

2145 3<sup>rd</sup> St.  
Kenner La.  
(mailing address)

WELL LOCATION:


sec. 40 T 8 S R 14 W  
2 miles N W of Bay St Leno  
(distance) (direction) (nearest town)

WELL PURPOSE: Home  
(home, irrigation, municipal, industrial)

WELL COMPLETION DATA:

- (1) diameter (inches) 2
- (2) total depth (feet) 162
- (3) static water level (feet) 2' below above top of ground.
- (4) casing Galv. Steel 157'  
(material) (depth)  
If telescope see back.  
(size)
- (5) screen 5' 157'  
(length) (depth to top)
- .012 2" S. Steel SS  
(size) (material)
- (6) pump 1/2 400  
(HP) (yield gpm)  
Elec  
(type power)
- (7) electric log NO  
(yes or no)  
(organization running log)
- (8) how well bottom plugged BW Value

description of formations encountered	from to	
Brown Mud	0	20
White Sand	20	32
Brown Mud	32	45
Mixed Brown Mud + Sand	45	82
Blue Clay	82	127
Grey Sand	127	157

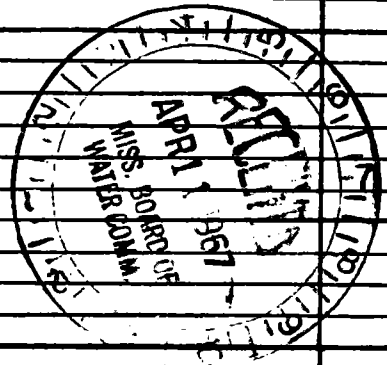

DRILLERS REMARKS:

Did Not Bottom sand

If well telescopes please sketch and show depths.

GROUND LEVEL

		X	

SECTION 40

Please indicate well location X.

ADDITIONAL INFORMATION

If more than one screen, show locations of each on sketch.