

MISSISSIPPI  
BOARD OF WATER COMMISSIONERS  
416 North State Street  
Jackson, Mississippi 39201

WATER WELL DRILLERS LOG

Hancock  
K 2153  
3-67

3-22 1967 SUTTER WELL WORKS Hancock  
date well completed firm name county well located

LANDOWNER: RICHARD COLLINS  
4716 ASHBURY DR.  
NEW ORLEANS, LA.  
(mailing address)


description of formations encountered	depth	
	from	to
Clay	0	230
sand	230	270
Clay - sand streak	270	470
sand	470	504

WELL LOCATION:  
sec. 37 T 8 N R 14 E  
S W of Bay St Louis  
(distance) (direction) (nearest town)

WELL PURPOSE: Home  
(home, irrigation, municipal, industrial)

- WELL COMPLETION DATA:
- (1) diameter (inches) 2"
  - (2) total depth (feet) 504'
  - (3) static water level (feet) 15 <sup>below</sup> ~~above~~ top of ground.
  - (4) casing GALV. 494'  
(material) (depth)  
(size) If telescope see back.
  - (5) screen 10' 494'  
(length) (depth to top)  
2" STAINLESS STEEL  
(size) (material)
  - (6) pump UNKNOWN  
(HP) (yield gpm)  
(type power)
  - (7) electric log No  
(yes or no)  
(organization running log)
  - (8) how well bottom plugged B.P. VALVE

DRILLERS REMARKS:

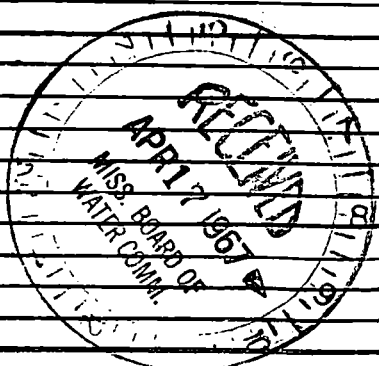

If well telescopes please sketch and show depths.

GROUND LEVEL

	X		
14		- 8	28

SECTION 37

Please indicate well location X.

ADDITIONAL INFORMATION

If more than one screen, show locations of each on sketch.