

MISSISSIPPI
 BOARD OF WATER COMMISSIONERS
 416 North State Street
 Jackson, Mississippi 39201

WATER WELL DRILLERS LOG

Hancock
 K2154
 3-67

3/23 1967 SUTTER Well Works Hancock
 date well completed firm name county well located

LANDOWNER: Geo. Hull

10020 ST. PAUL

New Orleans, LA.
 (mailing address)

description of formations encountered

from to

Clay	0	10
Sand	10	28
Clay	28	110
Sand	110	152

WELL LOCATION:

28⁰⁰ sec 8^W T 8^N R 14^E
 3 miles W Bay St Louis
 (distance) (direction) (nearest town)

WELL PURPOSE: Home
 (home, irrigation, municipal, industrial)

WELL COMPLETION DATA:

(1) diameter (inches) 2
 (2) total depth (feet) 152
 (3) static water level (feet) 2 below above top of ground.

(4) casing GALV. 147'
 (material) (depth)

(size) If telescope see back.

(5) screen 5' 147'
 (length) (depth to top)

2" STAINLESS STEEL
 (size) (material)

(6) pump 1/3 15
 (HP) (yield gpm)


ELEC
 (type power)

(7) electric log No
 (yes or no)

(organization running log)

(8) how well bottom plugged BP Valve

DRILLERS REMARKS:

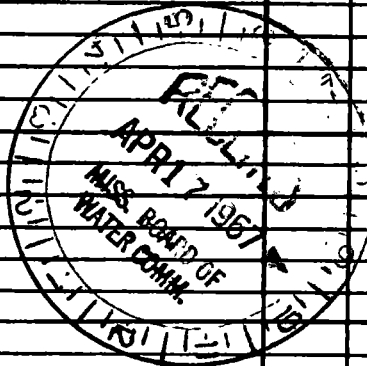

If well telescopes please sketch and show depths.

GROUND LEVEL

A 4x4 grid diagram. The top-right cell (row 1, column 4) contains an 'X'. To the left of the grid is a north arrow pointing upwards, labeled with 'N'.

			X

SECTION 47

Please indicate well location X.

ADDITIONAL INFORMATION

Multiple horizontal lines for writing additional information.

If more than one screen, show locations of each on sketch.