

Hancock
 K 2155
 4-67

MISSISSIPPI
 BOARD OF WATER COMMISSIONERS
 416 North State Street
 Jackson, Mississippi 39201

WATER WELL DRILLERS LOG

4-2 1967 Sutter Well Works Hancock
 date well completed firm name county well located

LANDOWNER: T. L. JAMES Co.

description of formations encountered	from	to
	Clay	0
Sand	70	82
Clay	82	140
Shale	140	165

Bryant-Louis, Miss.

(mailing address)

WELL LOCATION:

sec. 40 T. 8 N. R. 14 E. S. 4
 4 miles N of Bryant-Louis
 (distance) (direction) (nearest town)

WELL PURPOSE: Home
 (home, irrigation, municipal, industrial)


WELL COMPLETION DATA:

- (1) diameter (inches) 2
- (2) total depth (feet) 165
- (3) static water level (feet) 1 ^{below} above top of ground
- (4) casing Galv. 160'
 (material) (depth)
- (size) If telescope see back.
- (5) screen 5' 160'
 (length) (depth to top)
- 2" stainless steel
 (size) (material)
- (6) pump unknown
 (HP) (yield gpm)

(type power)
 (7) electric log no
 (yes or no)
 (organization running log)


(8) how well bottom plugged BP Valve

DRILLERS REMARKS:

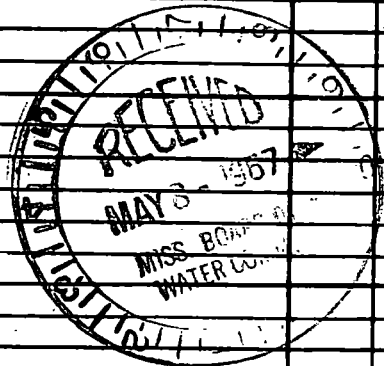

If well telescopes please sketch and show depths.

GROUND LEVEL

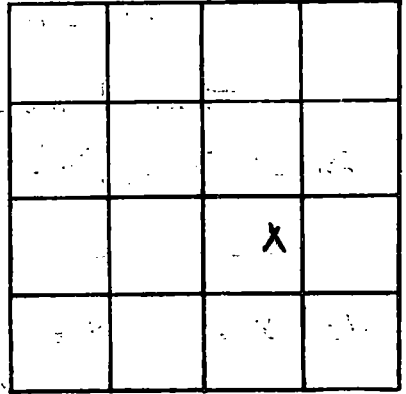

		X	

SECTION 40

Please indicate well location X.

ADDITIONAL INFORMATION

If more than one screen, show locations of each on sketch.