

Hancock
K 2156
4-67

MISSISSIPPI
BOARD OF WATER COMMISSIONERS
416 North State Street
Jackson, Mississippi 39201

WATER WELL DRILLERS LOG

4-19 1967 Sutton Well Works Hancock
date well completed firm name county well located


LANDOWNER: Louis Andrew
Barrow St.
New Orleans, La
(mailing address)

description of formations encountered	from	to
Clay	0	16
Sand	16	30
Clay	30	108
Sand	108	152

WELL LOCATION:
sec 40 T 8 S R 14 E W
5 miles W of Bay St Louis
(distance) (direction) (nearest town)

WELL PURPOSE: home
(home, irrigation, municipal, industrial)

- WELL COMPLETION DATA:
- (1) diameter (inches) 2
 - (2) total depth (feet) 152
 - (3) static water level (feet) 1 above
top of ground.
 - (4) casing Galv. 147'
(material) (depth)
 - if telescope see back.
(size)
 - (5) screen 5' 147'
(length) (depth to top)
 - 2" stainless steel
(size) (material)
 - (6) pump None
(HP) (yield gpm)
 - (type power)
 - (7) electric log no
(yes or no)
 - (organization running log)
 - (8) how well bottom plugged BP Value

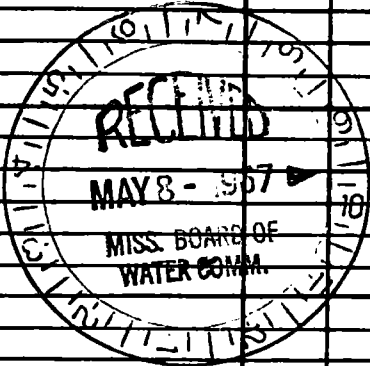

DRILLERS REMARKS: _____

If well telescopes please sketch and show depths.

GROUND LEVEL

A 4x4 grid diagram. To the left of the grid is a vertical arrow pointing upwards, with a wavy line below it. The bottom-right cell of the grid contains a handwritten 'X'.

			X

SECTION 40

Please indicate well location X.

ADDITIONAL INFORMATION

Lined area for additional information.

If more than one screen, show locations of each on sketch.