

Hancock
K 2157
4-67

MISSISSIPPI
BOARD OF WATER COMMISSIONERS
416 North State Street
Jackson, Mississippi 39201

WATER WELL DRILLERS LOG

4-19 1967 date well completed
Lutter Wood Works firm name
7 Hancock county well located

LANDOWNER: A.C. Marens

Rt. 1 Box 458

Bay St Louis Miss.
(mailing address)

description of formations encountered

from

to

old hole
Clay
Sand

0 111
111 142
142 160

WELL LOCATION:

sec. 40 T. 8 S. R. 14 W.
7 miles N of Bay St Louis
(distance) (direction) (nearest town)

WELL PURPOSE: home
(home, irrigation, municipal, industrial)

WELL COMPLETION DATA:

- (1) diameter (inches) 2 x 1 1/4
(2) total depth (feet) 160
(3) static water level (feet) 1 below above top of ground.
(4) casing galv. 155' (material) (depth)
1 1/4" (size) If telescope see back.
(5) screen 5' 155' (length) (depth to top)
2" (size) SS Stainless steel (material)
(6) pump unknown (HP) (yield gpm)


(type power)

- (7) electric log no (yes or no)

(organization running log)

- (8) how well bottom plugged B.P. Value

DRILLERS REMARKS:

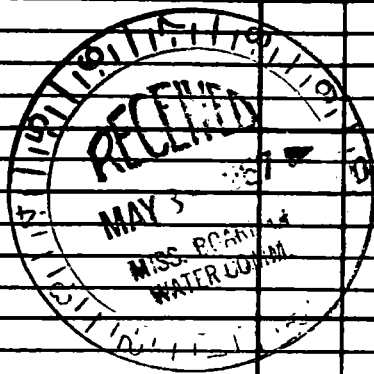


If well telescopes please sketch and show depths.

GROUND LEVEL

1 1/2" galvanized pipe

2 x 1 1/2" bushing to join 2" and 1 1/4"

2 x 5 stainless steel screens

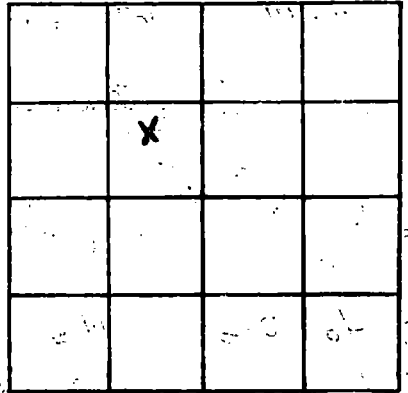

SECTION 40

Please indicate well location X.

ADDITIONAL INFORMATION

If more than one screen, show locations of each on sketch.