

Hancock  
 K2159  
 5-67

MISSISSIPPI  
 BOARD OF WATER COMMISSIONERS  
 416 North State Street  
 Jackson, Mississippi 39201

WATER WELL DRILLERS LOG

5-15 1967 Sutter Well Works Hancock  
 date well completed firm name county well located

LANDOWNER: Jos. HOTH  
 6419 PAINTERS  
 NEW ORLEANS LA.  
 (mailing address)  
 WELL LOCATION:  
 sec. 37 T 8 N R 14 E  
 S W  
 2 miles W of Baytown  
 (distance) (direction) (nearest town)

description of formations encountered	from	to
Surface sand	0	38
Clay	38	80
gravel	80	95
Clay	95	153
labeled sand	153	168
Clay	168	275
sand	275	291


WELL PURPOSE: Home  
 (home, irrigation, municipal, industrial)

- WELL COMPLETION DATA:
- (1) diameter (inches) 2
  - (2) total depth (feet) 291
  - (3) static water level (feet) 2 <sup>below</sup> ~~above~~ top of ground
  - (4) casing galv. 28' (material), (depth)  
 2" (size) if telescope see back.
  - (5) screen 10' 281' (length), (depth to top)  
 2" stainless steel (size), (material)
  - (6) pump Unknown (HP), (yield gpm)

(type power)  
 (7) electric log no (yes or no)


(organization running log)  
 (8) how well bottom plugged B.P. Valve

DRILLERS REMARKS:

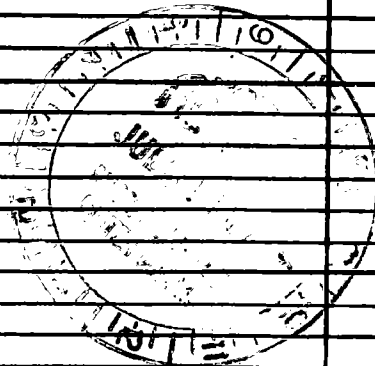

If well telescopes please sketch and show depths.

GROUND LEVEL

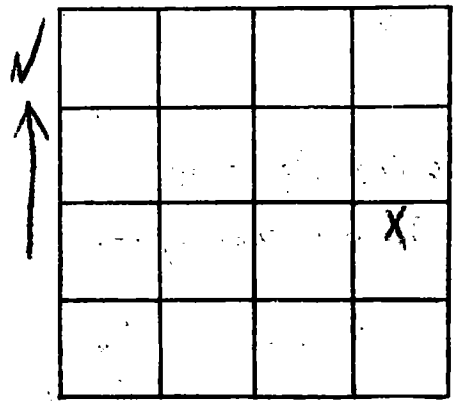

SECTION 37

Please indicate well location X.

ADDITIONAL INFORMATION

A series of horizontal lines for writing additional information, starting below the 'ADDITIONAL INFORMATION' header.

If more than one screen, show locations of each on sketch.