

Hancock
K 2160
5-67

MISSISSIPPI
BOARD OF WATER COMMISSIONERS
416 North State Street
Jackson, Mississippi 39201

WATER WELL DRILLERS LOG

5-25 1967 date well completed
Lutter Well Works firm name
Hancock county well located

LANDOWNER: RALPH RICHARDS

206 Bd. of Trade Canal
New Orleans La.
(mailing address)

WELL LOCATION:

sec. 37 T. 8 N. R. 14 E.
S W
2 miles (distance) N (direction) of Baytown (nearest town)

WELL PURPOSE: Home
(home, irrigation, municipal, industrial)

WELL COMPLETION DATA:

- (1) diameter (inches) 2
- (2) total depth (feet) 422
- (3) static water level (feet) 1 below top of ground.
- (4) casing galv. 412' (material), (depth), 2" (size) if telescope see back.
- (5) screen 10' 412' (length), (depth to top), 2" stainless steel (size), (material)
- (6) pump unknown (HP), (yield gpm)

(type power)

(7) electric log no (yes or no)

(organization running log)

(8) how well bottom plugged B.P. Valve



description of formations encountered	depth	
	from	to
Clay	0	10
sand	10	35
Clay	35	55
red sand	55	230
Clay	230	400
Sand	400	422

DRILLERS REMARKS:



If well telescopes please sketch and show depths.

GROUND LEVEL

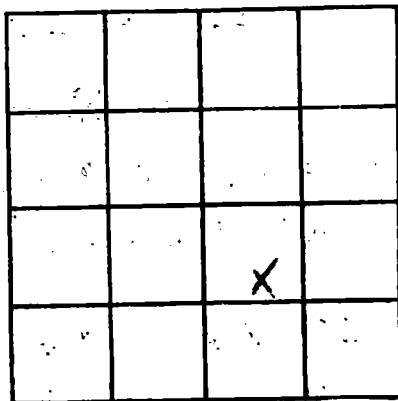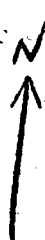

SECTION 37

Please indicate well location X.

ADDITIONAL INFORMATION

If more than one screen, show locations of each on sketch.