

HANCOCK
K 2162
6-67

MISSISSIPPI
BOARD OF WATER COMMISSIONERS
416 North State Street
Jackson, Mississippi 39201

WATER WELL DRILLERS LOG

6-20 1967 date well completed
Lutter Well Works firm name
Hancock county well located

LANDOWNER: M. CHAIX
921 N. Turnbull Ave.
METAIRIE LA.
(mailing address)

description of formations encountered	from	to
<u>Sand</u>	<u>0</u>	<u>40</u>
<u>Clay</u>	<u>40</u>	<u>113</u>
<u>Sand & gravel</u>	<u>113</u>	<u>131</u>

WELL LOCATION:
sec 33 T 8 N R 14 E
S W
3 miles NW of Bay St Louis
(distance) (direction) (nearest town)

WELL PURPOSE: home
(home, irrigation, municipal, industrial)

WELL COMPLETION DATA:


- (1) diameter (inches) 2
- (2) total depth (feet) 131
- (3) static water level (feet) 3 below top of ground.
- (4) casing Galv. 126'
(material) (depth)
- 2" if telescope see back.
(size)
- (5) screen 5' 126'
(length) (depth to top)
- 2" Stainless Steel
(size) (material)
- (6) pump Unknown
(HP) (yield gpm)

(type power)
(7) electric log no
(yes or no)

(organization running log)

(8) how well bottom plugged BP Valve

DRILLERS REMARKS:

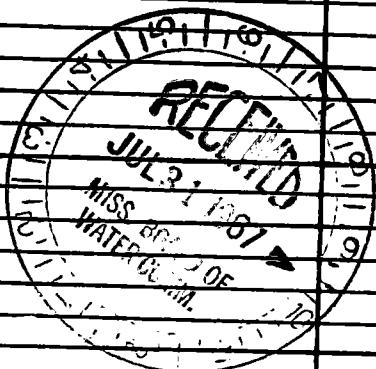

If well telescopes please sketch and show depths.

GROUND LEVEL

N
↑

X			

SECTION 33

Please indicate well location X.

ADDITIONAL INFORMATION

If more than one screen, show locations of each on sketch.