

HANCOCK
K 2163
7-67

MISSISSIPPI
BOARD OF WATER COMMISSIONERS
416 North State Street
Jackson, Mississippi 39201

WATER WELL DRILLERS LOG

7-1 19 67 date well completed
Lutter Well Works firm name
Hancock county well located

LANDOWNER: Chas. Lafontaine

description of formations encountered

from to

Rt. 3. Box 390

Bay St Louis Miss.
(mailing address)

Clay

0 10

Sand

10 37

Clay

37 133

Sand

133 152

WELL LOCATION:

sec. 33 T 8 R 14
S W
5 miles W of Bay St Louis
(distance) (direction) (nearest town)

WELL PURPOSE: home
(home, irrigation, municipal, industrial)

WELL COMPLETION DATA:

(1) diameter (inches) 2
(2) total depth (feet) 152
(3) static water level (feet) 6 below above top of ground.

(4) casing galv. 147'
(material) (depth)

2"
(size) if telescope see back.

(5) screen 5' 147'
(length) (depth to top)

2" stainless steel
(size) (material)

(6) pump 1/2 10
(HP) (yield gpm)


elec
(type power)

(7) electric log No
(yes or no)

(organization running log)

(8) how well bottom plugged B.P. Value

DRILLERS REMARKS:

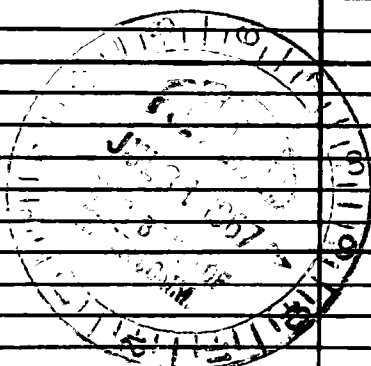

If well telescopes please sketch and show depths.

GROUND LEVEL



	X		

SECTION 33

Please indicate well location X.

ADDITIONAL INFORMATION

If more than one screen, show locations of each on sketch.