

Hancock  
 K 2164  
 7-67  
 7-1-67

MISSISSIPPI  
 BOARD OF WATER COMMISSIONERS  
 416 North State Street  
 Jackson, Mississippi 39201

WATER WELL DRILLERS LOG

1967 date well completed Sutton Well Works firm name Hancock county well located

LANDOWNER: K. Z. Broland  
614 Sixth  
Waveland Miss.  
 (mailing address)


WELL LOCATION:  
 sec. 37 T. 8 N. R. 14 E.  
S W  
2 miles W of Bay St. Louis  
 (distance) (direction) (nearest town)

WELL PURPOSE: Home  
 (home, irrigation, municipal, industrial)

WELL COMPLETION DATA:

- (1) diameter (inches) 2
- (2) total depth (feet) 282
- (3) static water level (feet) 1 below top of ground above
- (4) casing galv. 272'  
 (material) (depth)  
2" if telescope see back.  
 (size)
- (5) screen 10' 272'  
 (length) (depth to top)  
2" stainless steel  
 (size) (material)
- (6) pump 1/2 15  
 (HP) (yield gpm)  
elec  
 (type power)
- (7) electric log no  
 (yes or no)  
 (organization running log)
- (8) how well bottom plugged BP Values

description of formations encountered	from	to
Clay & fill	0	60
sand	60	65
clay	65	90
sand	90	132
Clay	132	170
sand	170	175
Clay	175	254
Redd	254	282

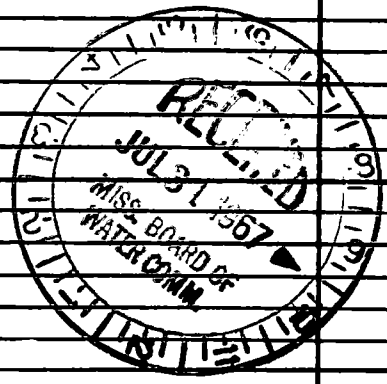

DRILLERS REMARKS:

If well telescopes please sketch and show depths.

GROUND LEVEL

		X	

SECTION 37

Please indicate well location X.

ADDITIONAL INFORMATION

If more than one screen, show locations of each on sketch.