

Hancock
R 21 65
7-67

MISSISSIPPI
BOARD OF WATER COMMISSIONERS
416 North State Street
Jackson, Mississippi 39201

WATER WELL DRILLERS LOG

7-25 19 67 date well completed
Sutter Well Works firm name
Hancock county well located

LANDOWNER: N H Fraenzel
131 Nursery Ave
Metairie La.
(mailing address)

description of formations encountered	from	to
Clay	0	10
Sand	10	36
Clay	36	90
Sand	90	126
Clay	126	155
Sand	155	170

WELL LOCATION:
sec. 40 T 8 S R 14 E
5 miles W of Bay St Louis
(distance) (direction) (nearest town)

WELL PURPOSE: home
(home, irrigation, municipal, industrial)


WELL COMPLETION DATA:

- (1) diameter (inches) 2
- (2) total depth (feet) 170
- (3) static water level (feet) 3 below above top of ground.
- (4) casing galv. 160'
(material) (depth)
2" if telescope see back.
(size)
- (5) screen 10' 160'
(length) (depth to top)
2" brass
(size) (material)
- (6) pump 1/2 10
(HP) (yield gpm)
elec
(type power)
- (7) electric log no
(yes or no)

(organization running log)


(8) how well bottom plugged BPU Value

DRILLERS REMARKS:

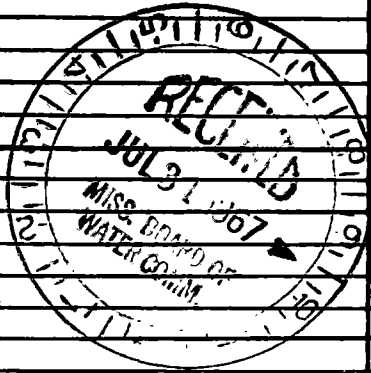

If well telescopes please sketch and show depths.

GROUND LEVEL

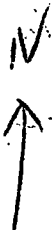

	X		

SECTION 40

Please indicate well location X.

ADDITIONAL INFORMATION

If more than one screen, show locations of each on sketch.