

Hancock  
K2160  
7-67

MISSISSIPPI  
BOARD OF WATER COMMISSIONERS  
416 North State Street  
Jackson, Mississippi 39201

WATER WELL DRILLERS LOG

7-27 1967 Sutter Wood Leblanc Hancock  
date well completed firm name county well located

LANDOWNER Leonard Waggett

description of formations encountered

from to

Court St

Bay St. Louis Miss.  
(mailing address)

Sand	0	26
Clay	26	80
sand	80	98
Clay	98	130
sand	130	152


WELL LOCATION:

sec. 33 T. 8 S. R. 14 E.  
3 miles SW of Bay St. Louis  
(distance) (direction) (nearest town)

WELL PURPOSE: home  
(home, irrigation, municipal, industrial)

WELL COMPLETION DATA:

- (1) diameter (inches) 2
- (2) total depth (feet) 152
- (3) static water level (feet) 4 below above top of ground.
- (4) casing galv. 147'  
(material) (depth)  
2" If telescope see back.  
(size)
- (5) screen 5' 147'  
(length) (depth to top)  
2" stainless steel  
(size) (material)
- (6) pump unknown  
(HP) (yield gpm)  
(type power)
- (7) electric log no  
(yes or no)  
(organization running log)
- (8) how well bottom plugged BP Value

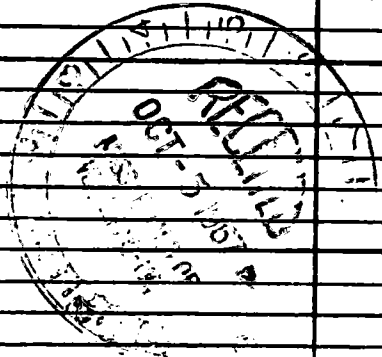

DRILLERS REMARKS:

If well telescopes please sketch and show depths.

GROUND LEVEL

		X	

33

SECTION 33

Please indicate well location X.

ADDITIONAL INFORMATION

If more than one screen, show locations of each on sketch.