

Hancock
 K 2167
 8-67

MISSISSIPPI
 BOARD OF WATER COMMISSIONERS
 416 North State Street
 Jackson, Mississippi 39201

WATER WELL DRILLERS LOG

8-9 1967 Sutter Well Works Hancock
 date well completed firm name county well located

LANDOWNER: Mrs. J. Murphy
 6220 Wainwright Dr.
 New Orleans La
 (mailing address)

description of formations encountered	from	to
Clay	0	10
Sand	10	47
Clay	47	115
Sand	115	173

WELL LOCATION:
 17 1/2 T 8 N R 14 E
 S
 5 miles NW of Bay St Louis
 (distance) (direction) (nearest town)

WELL PURPOSE: home
 (home, irrigation, municipal, industrial)


WELL COMPLETION DATA:

- (1) diameter (inches) 2
- (2) total depth (feet) 173
- (3) static water level (feet) 2 below above top of ground.
- (4) casing galv. 168'
 (material) (depth)
 2" if telescope see back.
 (size)
- (5) screen 5' 168'
 (length) (depth to top)
 2" Stainless Steel
 (size) (material)
- (6) pump unknown
 (HP) (yield gpm)

(type power)
 (7) electric log no (yes or no)
 (organization running log)

(8) how well bottom plugged BPU value

DRILLERS REMARKS:

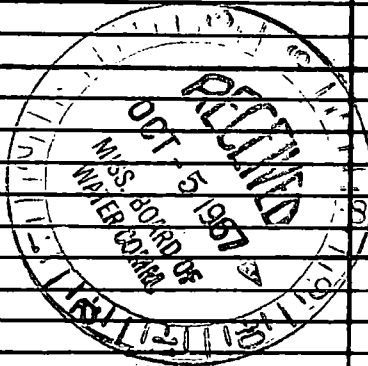

If well telescopes please sketch and show depths.

GROUND LEVEL

			X

SECTION 17

Please indicate well location X.

ADDITIONAL INFORMATION

If more than one screen, show locations of each on sketch.