

Hancock
K 2119
9-67

MISSISSIPPI
BOARD OF WATER COMMISSIONERS
416 North State Street
Jackson, Mississippi 39201

WATER WELL DRILLERS LOG

9-15 1967 Sutter Well Works Hancock
date well completed firm name county well located

LANDOWNER: J.L. INCARDONIA

description of formations encountered

from to

3901 TOHOUPITOULAS

Clay 0 16

New Orleans, La.
(mailing address)

sand 16 45

Clay 45 90

WELL LOCATION:

sand 90 98

sec 33 T8 N R 14 E
S W
2 miles SW of Bay St Louis
(distance) (direction) (nearest town)

Clay 98 120

sand 120 152

WELL PURPOSE: Home
(home, irrigation, municipal, industrial)

WELL COMPLETION DATA:

(1) diameter (inches) 2
(2) total depth (feet) 152
(3) static water level (feet) 5 below above top of ground.

(4) casing galv. 147'
(material) (depth)

2" If telescope see back.
(size)

(5) screen 5' 147'
(length) (depth to top)

2" Stainless Steel
(size) (material)

(6) pump 3/4 12
(HP) (yield gpm)


elec
(type power)

(7) electric log no
(yes or no)

(organization running log)

(8) how well bottom plugged BP Value

DRILLERS REMARKS:

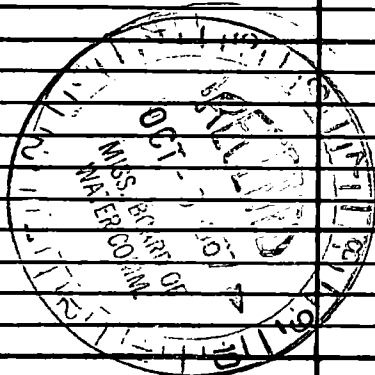

If well telescopes please sketch and show depths.

GROUND LEVEL

X			

SECTION 33

Please indicate well location X.

ADDITIONAL INFORMATION

If more than one screen, show locations of each on sketch.