

Hancock
K 2190
9-67

MISSISSIPPI
 BOARD OF WATER COMMISSIONERS
 416 North State Street
 Jackson, Mississippi 39201

WATER WELL DRILLERS LOG

Sept. 22 1967 M&B Drilling Co. Hancock
 date well completed firm name county well located

LANDOWNER: Shavers

Shoreline Park

Bay St. Louis
 (mailing address)

description of formations encountered

from to

Fill	0	3
Swamp	3	6
Mud & Half Colored Clay	6	15
Coarse Sand (white)	15	43
Soft Gray Clay	43	55
Coarse White Sand	55	65
Blue Clay	65	95
Fire Sand	95	100
Blue Clay Sand Breaker	100	140
Blue Clay	140	160
Grey Sand	160	185

WELL LOCATION:

sec 28 T 8 R 14
 S W
2 miles W of Bay St. Louis
 (distance) (direction) (nearest town)

WELL PURPOSE: Home - Tractor
 (home, irrigation, municipal, industrial)

WELL COMPLETION DATA:

- diameter (inches) 4x2
- total depth (feet) 185
- static water level (feet) 2 below top of ground
- casing PVC 175
 (material) (depth)
4x2 If telescope see back.
 (size)
- screen 10ft 175
 (length) (depth to top)
2" Sand Pac PK
 (size) (material)
- pump 1/2 20
 (HP) (yield gpm)
220 V 1φ
 (type power)
- electric log No
 (yes or no)
Submersible Pump
 (organization running log)
- how well bottom plugged PVC Cap



DRILLERS REMARKS:

Scars Boebuck Job

If well telescopes please sketch and show depths.


GROUND LEVEL

100 FT
4" PVC

100

2" PVC

175 10 FT PVC
Sand Screen
185

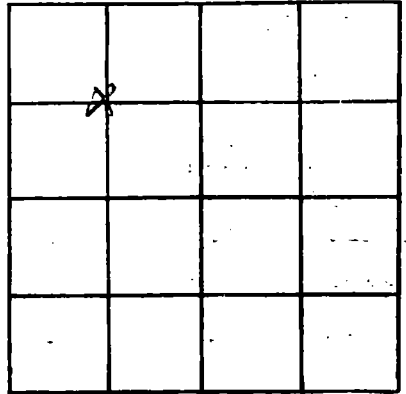

SECTION 28

Please indicate well location X.

ADDITIONAL INFORMATION

If more than one screen, show locations of each on sketch.