

Hancock
K 2172
9-67

MISSISSIPPI
BOARD OF WATER COMMISSIONERS
416 North State Street
Jackson, Mississippi 39201

WATER WELL DRILLERS LOG

9-26 1967 Sutter Well Works Hancock
date well completed firm name county well located

LANDOWNER: G K Miller

Rt. 2 Box 685

Bay St Louis Miss.
(mailing address)

WELL LOCATION:

sec. 40 T. 8 N R. 14 E
S W
4 miles NW of Bay St Louis
(distance) (direction) (nearest town)

WELL PURPOSE: home
(home, irrigation, municipal, industrial)

WELL COMPLETION DATA:

- (1) diameter (inches) 2
- (2) total depth (feet) 154
- (3) static water level (feet) 1/2 below top of ground
- (4) casing galv. 149'
(material) (depth)
- 2" If telescope see back.
(size)
- (5) screen 5' 149'
(length) (depth to top)
- 2" Stainless Steel
(size) (material)
- (6) pump submersible
(HP) (yield gpm)

(type power)

(7) electric log no
(yes or no)

(organization running log)

(8) how well bottom plugged BPU value


DRILLERS REMARKS:

description of formations encountered

from

to

Clay	0	18
sand	18	35
Clay	35	140
sand	140	154

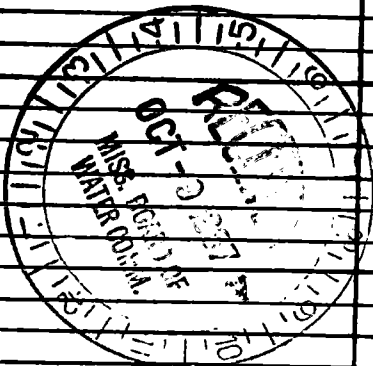

If well telescopes please sketch and show depths.

GROUND LEVEL

X			

SECTION 40

Please indicate well location X.

ADDITIONAL INFORMATION

If more than one screen, show locations of each on sketch.