

Hancock
K2193
9-67

MISSISSIPPI
BOARD OF WATER COMMISSIONERS
416 North State Street
Jackson, Mississippi 39201

WATER WELL DRILLERS LOG

9-27 1967 date well completed
Lutter Well Works firm name
Hancock county well located

LANDOWNER: JOHN KRAMER

BAY ST. LOUIS

Miss.

(mailing address)

WELL LOCATION:

37 ~~4~~ sec. 8 T 8 N R 14 E S W
2 miles NW of Bay St Louis
(distance) (direction) (nearest town)

WELL PURPOSE: home
(home, irrigation, municipal, industrial)

WELL COMPLETION DATA:

- (1) diameter (inches) 2
(2) total depth (feet) 430
(3) static water level (feet) 2 ^{below} _{above} top of ground.
(4) casing galv. 420'
(material) (depth)
2" if telescope see back.
(size)
(5) screen 10' 420'
(length) (depth to top)
2" Stainless steel
(size) (material)
(6) pump 1 18
(HP) (yield gpm)
elec
(type power)
(7) electric log no
(yes or no)


(organization running log)

(8) how well bottom plugged BPU value

description of formations encountered

from to


Clay	0	8
sand	8	36
Clay	36	138
sand	138	160
Clay	160	172
sand	172	215
Clay	215	327
sand	327	340
Clay	340	369
sand	369	430

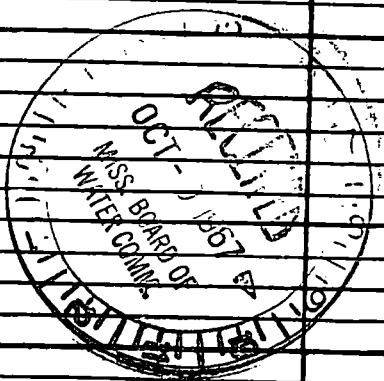

DRILLERS REMARKS:

If well telescopes please sketch and show depths.

GROUND LEVEL

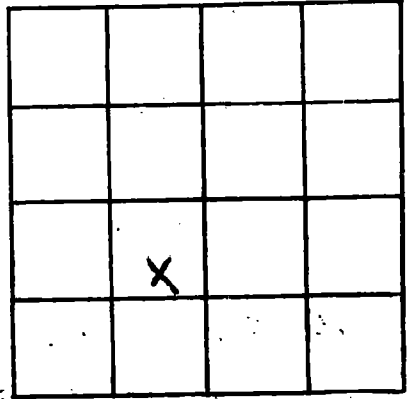

SECTION 46

Please indicate well location X.

ADDITIONAL INFORMATION

If more than one screen, show locations of each on sketch.