

Hancock
12174
10-67

MISSISSIPPI
 BOARD OF WATER COMMISSIONERS
 416 North State Street
 Jackson, Mississippi 39201

WATER WELL DRILLERS LOG

10-26-1967 date well completed Little Well Works firm name Hancock county well located

LANDOWNER: Milton James
3918 Ford St
New Orleans, La.
 (mailing address)

description of formations encountered	from	to
<u>Sand + gravel</u>	<u>0</u>	<u>135</u>
<u>Clay</u>	<u>135</u>	<u>401</u>
<u>Sand</u>	<u>401</u>	<u>426</u>

WELL LOCATION:
40~~th~~ sec. 8 T 8 N R 14 W
4 miles W of Bay St Louis
 (distance) (direction) (nearest town)

WELL PURPOSE: Home
 (home, irrigation, municipal, industrial)

WELL COMPLETION DATA:

- (1) diameter (inches) 2
- (2) total depth (feet) 426
- (3) static water level (feet) 2 below above top of ground.
- (4) casing galv. (material), 416' (depth)
2" (size) if telescope see back.
- (5) screen 10' (length), 416' (depth to top)
2" (size), stainless steel (material)
- (6) pump none (HP), (yield gpm)


(type power)

(7) electric log no (yes or no)

(organization running log)

(8) how well bottom plugged BP Value

DRILLERS REMARKS:

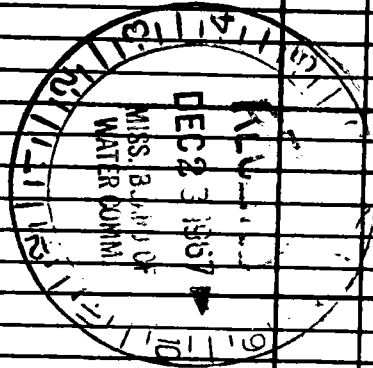

If well telescopes please sketch and show depths.

GROUND LEVEL

X			

SECTION 26

Please indicate well location X.

ADDITIONAL INFORMATION

If more than one screen, show locations of each on sketch.