

Hancock  
K2177  
12-67  
12/1/67

MISSISSIPPI  
 BOARD OF WATER COMMISSIONERS  
 416 North State Street  
 Jackson, Mississippi 39201

WATER WELL DRILLERS LOG

date well completed 1967 Butter Well Works firm name Hancock county well located

LANDOWNER: M. A. Payne

description of formations encountered	from	to
<u>Clay</u>	<u>0</u>	<u>40</u>
<u>sand &amp; gravel</u>	<u>40</u>	<u>95</u>
<u>Clay</u>	<u>95</u>	<u>180</u>
<u>sand</u>	<u>180</u>	<u>192</u>
<u>Clay</u>	<u>192</u>	<u>221</u>
<u>sand</u>	<u>221</u>	<u>273</u>
<u>Clay</u>	<u>273</u>	<u>384</u>
<u>sand</u>	<u>384</u>	<u>431</u>

Bot 1316

Bay St. Louis Miss.  
 (mailing address)

WELL LOCATION:

sec. 37 T. 8 S. R. 14 E. W. W  
 (distance) 2 miles (direction) W of Bay St. Louis (nearest town)


WELL PURPOSE: Home  
 (home, irrigation, municipal, industrial)

WELL COMPLETION DATA:

- (1) diameter (inches) 2
- (2) total depth (feet) 431
- (3) static water level (feet) 2 <sup>below</sup> above top of ground.
- (4) casing galv. (material), 421' (depth)  
2" (size) if telescope see back.
- (5) screen 10' (length), 421' (depth to top)  
2" (size), Stainless Steel (material)
- (6) pump none (HP), (yield gpm)  
elec (type power)
- (7) electric log no (yes or no)  
 (organization running log)

(8) how well bottom plugged B.P. value 2

DRILLERS REMARKS:

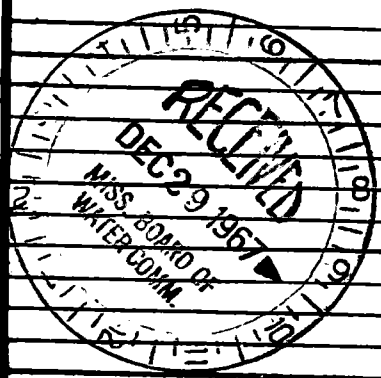

If well telescopes please sketch and show depths.

GROUND LEVEL

01 621  
 02 621  
 03 622  
 04 623  
 05 624  
 06 625

	X		

SECTION 37

Please indicate well location X.

ADDITIONAL INFORMATION

[Lined area for additional information with faint handwritten notes and arrows.]

If more than one screen, show locations of each on sketch.