

Hancock
 R 2178
 12-67

MISSISSIPPI
 BOARD OF WATER COMMISSIONERS
 416 North State Street
 Jackson, Mississippi 39201

WATER WELL DRILLERS LOG

12-4 1967 date well completed
 Sutter Well Works firm name
 Hancock county well located

LANDOWNER: HATTIESBURG POLICE
 FISHING CLUB

description of formations encountered	depth	
	from	to
sand	0	30
clay	30	58
sand	58	71
clay	71	132
sand	132	152


Hattiesburg, Miss.
 (mailing address)

WELL LOCATION:
 sec. 30 T 8 N R 14 W
 S W
 5 miles W Bay St Louis
 (distance) (direction) (nearest town)

WELL PURPOSE: sub-division
 (home, irrigation, municipal, industrial)

WELL COMPLETION DATA:

- (1) diameter (inches) 2
- (2) total depth (feet) 152
- (3) static water level (feet) 1 ^{above}
 top of ground.
- (4) casing galv. 147'
 (material) (depth)
2"
 (size) if telescope see back.
- (5) screen 5' 147'
 (length) (depth to top)
2" Stainless steel
 (size) (material)
- (6) pump 1 15
 (HP) (yield gpm)
elec
 (type power)
- (7) electric log no
 (yes or no)
 (organization running log)
- (8) how well bottom plugged BP Valve

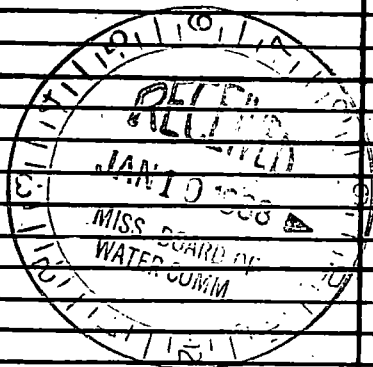

DRILLERS REMARKS:

If well telescopes please sketch and show depths.

GROUND LEVEL

58
52
47
49
41

58
52
47
49
41

	X		

SECTION 30

Please indicate well location X.

ADDITIONAL INFORMATION

If more than one screen, show locations of each on sketch.