

Hancock
 152199
 12-67

MISSISSIPPI
 BOARD OF WATER COMMISSIONERS
 416 North State Street
 Jackson, Mississippi 39201

WATER WELL DRILLERS LOG

12-8 1967 date well completed
 Sutter Well Works firm name
 Hancock county well located

LANDOWNER: HATTIESBURG
POLICE FISHING CLUB

description of formations encountered	depth	
	from	to
Sand	0	30
Clay	30	60
Sand	60	70
Clay	70	132
Sand	132	152

Hattiesburg Miss.
 (mailing address)

WELL LOCATION:

sec. 31 T. 8 N. R. 14 W.
4 miles W of Waveland
 (distance) (direction) (nearest town)

WELL PURPOSE: sub-division
 (home, irrigation, municipal, industrial)


WELL COMPLETION DATA:

- (1) diameter (inches) 2
- (2) total depth (feet) 152
- (3) static water level (feet) 1/2 below top of ground. above
- (4) casing galv. 147'
 (material) (depth)
2" if telescope see back.
 (size)
- (5) screen 5' 147'
 (length) (depth to top)
2" stainless steel
 (size) (material)
- (6) pump 1 20
 (HP) (yield gpm)
elec
 (type power)
- (7) electric log no
 (yes or no)

(organization running log)

(8) how well bottom plugged B.P. Value

DRILLERS REMARKS:

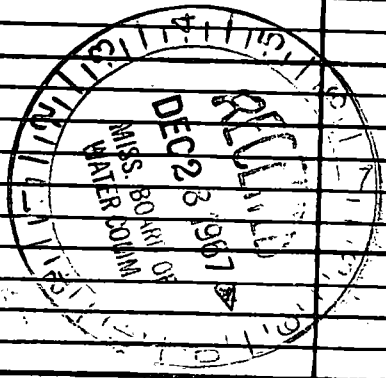

If well telescopes please sketch and show depths.

GROUND LEVEL

	X		

SECTION 31

Please indicate well location X.

ADDITIONAL INFORMATION

If more than one screen, show locations of each on sketch.