

Hancock
 152180
 12-67

MISSISSIPPI
 BOARD OF WATER COMMISSIONERS
 416 North State Street
 Jackson, Mississippi 39201

WATER WELL DRILLERS LOG

12-20 1967 Lutter Well Works Hancock
 date well completed firm name county well located

LANDOWNER: L & A Construction
 Gulfport, Miss.

description of formations encountered	from to	
Clay	0	20
sand	20	51
Clay	51	85
sand	85	125
Clay	125	320
sand	320	352

(mailing address)

WELL LOCATION:


sec. 9 T. 8 S. R. 14 E. W.
 6 miles NW of Bayston
 (distance) (direction) (nearest town)

WELL PURPOSE: Industrial
 (home, irrigation, municipal, industrial)

WELL COMPLETION DATA:

- (1) diameter (inches) 3 x 4
- (2) total depth (feet) 352
- (3) static water level (feet) 2 ^{below} above top of ground.
- (4) casing bet steel 336' (material) (depth)
 3 1/4" (size) If telescope see back.
- (5) screen 16' 336' (length) (depth to top)
 3" Stainless steel (size) (material)
- (6) pump 1 15 (HP) (yield gpm)
 elec (type power)
- (7) electric log no (yes or no)
 (organization running log)
- (8) how well bottom plugged B.P. Valve

DRILLERS REMARKS:

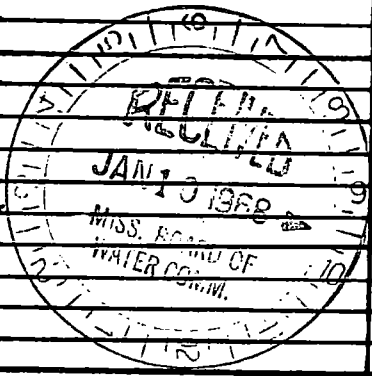

If well telescopes please sketch and show depths.

GROUND LEVEL

	BL		
X			
	X		

SECTION 9

Please indicate well location X.

ADDITIONAL INFORMATION

If more than one screen, show locations of each on sketch.