

Hancock  
R 2181  
1-68

MISSISSIPPI  
 BOARD OF WATER COMMISSIONERS  
 416 North State Street  
 Jackson, Mississippi 39201

WATER WELL DRILLERS LOG

1-3 1968 Sutter Well Works Hancock  
 date well completed firm name county well located

LANDOWNER: Adam Olivier  
Jordan River Sales  
Box St Louis Miss.  
 (mailing address)

WELL LOCATION:  
 sec 37 T 8 R 14 E  
 S W  
2 miles NW of Bay St Louis  
 (distance) (direction) (nearest town)


WELL PURPOSE: home  
 (home, irrigation, municipal, industrial)

WELL COMPLETION DATA:

- (1) diameter (inches) 2
- (2) total depth (feet) 430
- (3) static water level (feet) 3 <sup>below</sup>/<sub>above</sub> top of ground.
- (4) casing galv. 420'  
 (material) (depth)  
2" if telescope see back.  
 (size)
- (5) screen 10' 420'  
 (length) (depth to top)  
2" stainless steel  
 (size) (material)
- (6) pump 1/3 33 10  
 (HP) (yield gpm)  
elec  
 (type power)
- (7) electric log no  
 (yes or no)  
 (organization running log)
- (8) how well bottom plugged B.P. Value

DRILLERS REMARKS:

description of formations encountered	from	to
Clay + sand streaks	0	45
sand + gravel	45	90
Clay	90	135
sand	135	155
Clay	155	212
Clay - sand streaks	212	295
Clay	295	330
sand	330	340
Clay	340	395
	395	430

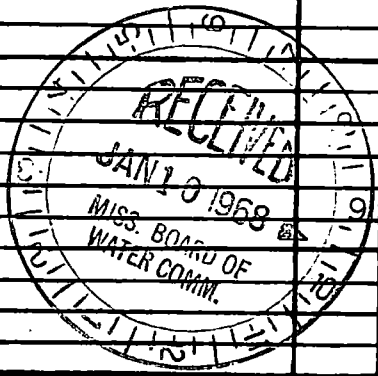

If well telescopes please sketch and show depths.

GROUND LEVEL

*[Faint handwritten notes and sketches on the left side of the page, including a vertical line and some illegible text.]*


SECTION 37

Please indicate well location X.

ADDITIONAL INFORMATION

*[A series of horizontal lines for additional information, with some faint handwritten notes.]*

If more than one screen, show locations of each on sketch.