

Hancock
K2183
1-68

MISSISSIPPI
BOARD OF WATER COMMISSIONERS
416 North State Street
Jackson, Mississippi 39201

WATER WELL DRILLERS LOG

1-4 1968 Sutton Well Works Hancock
date well completed firm name county well located

LANDOWNER: J. J. Purser
10,910 Chef Manteau
New Orleans La.
(mailing address)


description of formations encountered	from	to
Clay	0	20
Sand	20	35
Clay	35	95
Sand	95	150

WELL LOCATION:
sec. 17 T. 8 R. 14
S W E
5 miles W of Bay St Louis
(distance) (direction) (nearest town)

WELL PURPOSE: Home
(home, irrigation, municipal, industrial)

WELL COMPLETION DATA:

- (1) diameter (inches) 2
- (2) total depth (feet) 150
- (3) static water level (feet) 0 below above top of ground.
- (4) casing galv. 145'
(material) (depth)
2" if telescope see back.
(size)
- (5) screen 5' 145'
(length) (depth to top)
2" stainless steel
(size) (material)
- (6) pump unknown
(HP) (yield gpm)
(type power)
- (7) electric log No
(yes or no)
(organization running log)
- (8) how well bottom plugged BP Valve

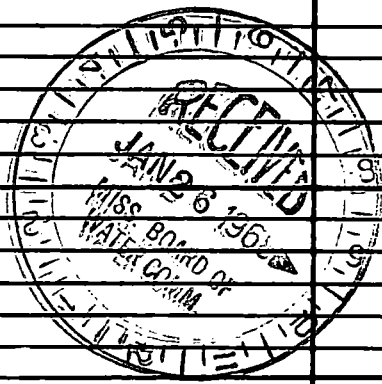

DRILLERS REMARKS:

