

Hancock
K2200
8-26-68

MISSISSIPPI
 BOARD OF WATER COMMISSIONERS
 416 North State Street
 Jackson, Mississippi 39201

WATER WELL DRILLERS LOG

8-26 1968 date well completed Sutter Well Works firm name Hancock county well located

LANDOWNER: Dr. Jos. Callaway
16250 Philip Hickey Dr.
Baton Rouge, La. 70808
 (mailing address)


description of formations encountered	from	to
Clay	0	12
sand	12	33
Clay	33	78
sand	78	96
Clay	96	130
sand	130	173

WELL LOCATION:
 sec. 28 T 8 N 5 S R 14 E
4 miles NW of Baptist
 (distance) (direction) (nearest town)

WELL PURPOSE: home
 (home, irrigation, municipal, industrial)

WELL COMPLETION DATA:

- (1) diameter (inches) 2
- (2) total depth (feet) 173
- (3) static water level (feet) 3 below above top of ground.
- (4) casing Galv., 168'
 (material) (depth)
2"
 (size) If telescope see back.
- (5) screen 5', 168'
 (length) (depth to top)
2", stainless steel
 (size) (material)
- (6) pump 1/2 10
 (HP) (yield gpm)
elec
 (type power)
- (7) electric log no
 (yes or no)
 (organization running log)
- (8) how well bottom plugged B.P. Value

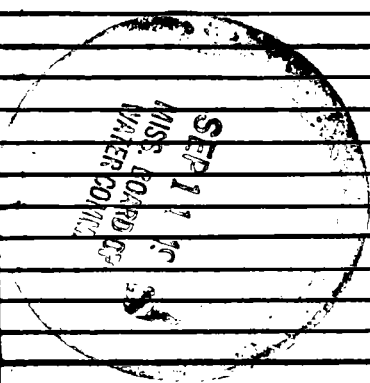

DRILLERS REMARKS:

