

Hancock
K 2202
5/8/77

136

MISSISSIPPI
BOARD OF WATER COMMISSIONERS
416 North State Street
Jackson, Mississippi 39201

WATER WELL DRILLERS LOG

May 4 1977 Hancock Well works Hancock
date well completed firm name county well located

LANDOWNER: Craig Liles
Box 64, Rainiers
(mailing address)

description of formations encountered	from	to
Blue mud	0	10
Sand	10	20
Sand	20	30
Clay Blue	30	40
Clay Blue	40	50
Clay Blue	50	60
Sand	60	70
Sand	70	80
Sand	80	90

WELL LOCATION:
2 sec. 39T 9N R 14E
0.5 miles E of R.S.L.
(distance) (direction) (nearest town)

WELL PURPOSE:
(home irrigation, municipal, industrial)

WELL COMPLETION DATA:

(1) diameter (inches) 2

(2) total depth (feet) 90

(3) static water level (feet) 7 below above top of ground.

(4) casing plastic 90
(material) (depth)
(size) If telescope see back.

(5) screen 5 90
(length) (depth to top)
2 plastic
(size) (material)

(6) pump 1/2 HP field gpm
1/2 HP
(type power)

(7) electric log (yes or no)

(organization running log)

(8) how well bottom plugged B.W.V.


DRILLERS REMARKS:

RECEIVED
MAR 16 1977

MISS. BD. OF WATER COMM

If well telescopes please sketch and show depths.

GROUND LEVEL

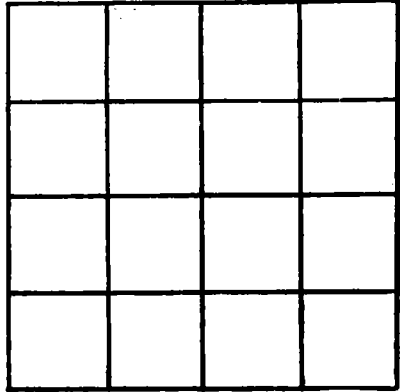

SECTION _____

Please indicate well location X.

ADDITIONAL INFORMATION

If more than one screen, show locations of each on sketch.