

**HANCOCK**  
**K 2984**  
**8-5-75**

**MISSISSIPPI**  
**BOARD OF WATER COMMISSIONERS**  
 416 North State Street  
 Jackson, Mississippi 39201

135

**WATER WELL DRILLERS LOG**

*HANCOCK*

Aug. 5 - 1975  
 date well completed

135 *one Bill Well works*  
 firm name

county well located

LANDOWNER: *Mr. Maki*  
 *Rt. 3 Box 187 F*  
 *Bay St. Louis Ms.*  
 (mailing address)

| description of formations encountered | from       | to         |
|---------------------------------------|------------|------------|
| <i>clay</i>                           | <i>0</i>   | <i>20</i>  |
| <i>sand</i>                           | <i>20</i>  | <i>38</i>  |
| <i>course sand</i>                    | <i>38</i>  | <i>71</i>  |
| <i>shush</i>                          | <i>71</i>  | <i>94</i>  |
| <i>fine sand</i>                      | <i>94</i>  | <i>132</i> |
| <i>Blue clay</i>                      | <i>132</i> | <i>167</i> |
| <i>fine sand</i>                      | <i>167</i> | <i>210</i> |
| <i>shush</i>                          | <i>210</i> | <i>258</i> |
| <i>shush</i>                          | <i>258</i> | <i>272</i> |
| <i>Blue clay</i>                      | <i>272</i> | <i>300</i> |
| <i>fine sand</i>                      | <i>300</i> | <i>379</i> |
| <i>course sand</i>                    | <i>379</i> | <i>400</i> |

WELL LOCATION:  
 sec. *09* T. *8* N. R. *14* E.  
*5* miles *NW* of *Bay St. Louis*  
 (distance) (direction) (nearest town)

WELL PURPOSE: *Home*  
 (home, irrigation, municipal, industrial)

WELL COMPLETION DATA:

(1) diameter (inches) *2"*

(2) total depth (feet) *400'*

(3) static water level (feet) *1'*  below  above top of ground

(4) casing *20' 40'* *390'*  
 (material) (depth)

*—* If telescope see back.  
 (size)

(5) screen *10'*  
 (length) (depth to top)  
*2"* *S.S.*  
 (size) (material)


(6) pump *1* *10*  
 (HP) (yield gpm)  
*Electric*  
 (type power)

(7) electric log *no*  
 (yes or no)

*—*  
 (organization running log)

(8) how well bottom plugged *sand*  
*shush*

DRILLERS REMARKS:

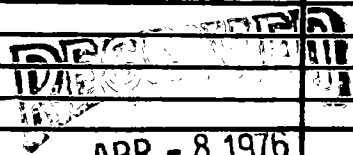

APR - 8 1976

MISS. RD. OF WATER COMM.

