

Hancock
K 2206
9-11-75

MISSISSIPPI
 BOARD OF WATER COMMISSIONERS
 416 North State Street
 Jackson, Mississippi 39201

WATER WELL DRILLERS LOG

9-11-75

Sutter Well Works


Hancock

date well completed

firm name

county well located

LANDOWNER: J. S. Brannon Tarpon Drive Garden Island	description of formations encountered	from	to
Bay St. Louis, Miss. (mailing address)	Clay	0	18
	Sand	18	60
	Clay	60	336
	Sand	336	476
WELL LOCATION:			
sec <u>22</u> T <u>8</u> S R <u>14</u> E <u>2 1/2</u> miles <u>NW</u> of <u>Bay St. Louis</u> (distance) (direction) (nearest town)			
WELL PURPOSE: Home (home, irrigation, municipal, industrial)			
WELL COMPLETION DATA:			
(1) diameter (inches) <u>2"</u>			
(2) total depth (feet) <u>476'</u>			
(3) static water level (feet) <u>1/2</u> ^{below} above top of ground.			
(4) casing <u>galv.</u> <u>466'</u> (material) (depth) <u>2"</u> (size) If telescope see back.			
(5) screen <u>10"</u> <u>466'</u> (length) (depth to top) <u>2"</u> stainless steel (size) (material)			
(6) pump <u>owner's</u> (HP) (yield gpm) (type power)			
(7) electric log <u>no</u> (yes or no)			
(organization running log)			
(8) how well bottom plugged <u>B.P. Valve</u>			
DRILLERS REMARKS:			

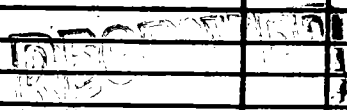

DEC 11 1975

MISS. Bd. OF WATER COMM

If well telescopes please sketch and show depths.

GROUND LEVEL

		0.712	0.000
X	1.0	1.0	1.0

SECTION 22

Please indicate well location X.

ADDITIONAL INFORMATION

If more than one screen, show locations of each on sketch.