

Hancock
R 2207
10-6-75

MISSISSIPPI
 BOARD OF WATER COMMISSIONERS
 416 North State Street
 Jackson, Mississippi 39201

WATER WELL DRILLERS LOG

10-6- 1975 Woodwell Drilling Hancock
 date well completed firm name county well located


LANDOWNER	description of formations encountered	from	to
<u>R. Artiguez</u>	<u>fill & clay</u>	<u>0</u>	<u>2.0</u>
<u>Fiber St.</u>	<u>sd</u>	<u>20</u>	<u>36</u>
<u>Bay St. Louis, miss.</u>	<u>clay</u>	<u>36</u>	<u>75</u>
(mailing address)	<u>sd w/ grey clay</u>	<u>75</u>	<u>136</u>
WELL LOCATION:	<u>clay</u>	<u>136</u>	<u>175</u>
sec. <u>32</u> T- <u>28</u> N	<u>sd</u>	<u>175</u>	<u>182</u>
R- <u>14</u> E ¹³⁵	<u>clay w/ reefs</u>	<u>182</u>	<u>480</u>
<u>1</u> miles <u>N</u> of <u>B.S.L.</u>	<u>of 17th St. State</u>	<u>480</u>	<u>505</u>
(distance) (direction) (nearest town)	<u>sd</u>		
WELL PURPOSE: <u>Home</u>			
(home, irrigation, municipal, industrial)			
WELL COMPLETION DATA:			
(1) diameter (inches) <u>2"</u>			
(2) total depth (feet) <u>505</u>			
(3) static water level (feet) <u>10</u> <u>below</u> <u>above</u> top of ground.			
(4) casing <u>PVC</u> <u>490</u>			
(material) (depth)			
(size) If telescope see back.			
(5) screen <u>15'</u>			
(length) (depth to top)			
<u>2"</u> <u>PVC</u>			
(size) (material)			
(6) pump <u>1/2</u> <u>10</u>			
(HP) (yield gpm)			
<u>elec.</u>			
(type power)			
(7) electric log <u>NO</u>			
(yes or no)			
<u>N/A</u>			
(organization running log)			
(8) how well bottom plugged <u>BW</u>			
DRILLERS REMARKS: <u>well flowing</u>			
<u>approx 20 gal. Per min</u>			
<u>5th Press.</u>			

REGISTERED
 NOV 12 1975

MISS. BD. OF WATER COMMISSIONERS

If well telescopes please sketch and show depths.

GROUND LEVEL

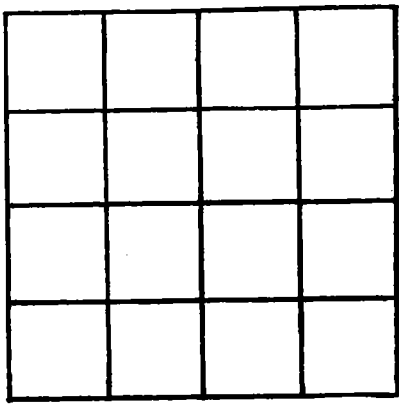

SECTION 37

Please indicate well location X.

ADDITIONAL INFORMATION

Lined area for additional information.

If more than one screen, show locations of each on sketch.