

Hancock  
K 2208  
10-10-75

MISSISSIPPI  
 BOARD OF WATER COMMISSIONERS  
 416 North State Street  
 Jackson, Mississippi 39201

WATER WELL DRILLERS LOG

10-10- 1975 Wood Well Drilling Hancock  
 date well completed firm name county well located

LANDOWNER: T. Champagne  
General Delivery  
Kaln, Miss.  
 (mailing address)

description of formations encountered	from	to
<u>top Soil - clay</u>	<u>0</u>	<u>2.6</u>
<u>sd</u>	<u>2.6</u>	<u>7.7</u>
<u>clay</u>	<u>7.7</u>	<u>15.5</u>
<u>sd</u>	<u>15.5</u>	<u>17.2</u>
<u>clay &amp; silt</u>	<u>17.2</u>	<u>24.0</u>
<u>sd</u>	<u>24.0</u>	<u>27.0</u>

WELL LOCATION:  
 sec. 20 T. 2 N. R. 14 E. 135  
2 miles N/E of Kaln  
 (distance) (direction) (nearest town)

WELL PURPOSE: Home  
 (home, irrigation, municipal, industrial)

- WELL COMPLETION DATA:
- (1) diameter (inches) 2"
  - (2) total depth (feet) 270
  - (3) static water level (feet) 20 below above top of ground.
  - (4) casing PVC, 260,  
 (material) (depth)  
 (size) if telescope see back.
  - (5) screen 10', -  
 (length) (depth to top)  
2", PVC  
 (size) (material)
  - (6) pump 1, 12  
 (HP) (yield gpm)  
Elec.  
 (type power)
  - (7) electric log NO  
 (yes or no)  
N/A  
 (organization running log)
  - (8) how well bottom plugged BWV


DRILLERS REMARKS: N/A

NOV 12 1975

MISS. BD. OF WATER COMM

If well telescopes please sketch and show depths.

GROUND LEVEL

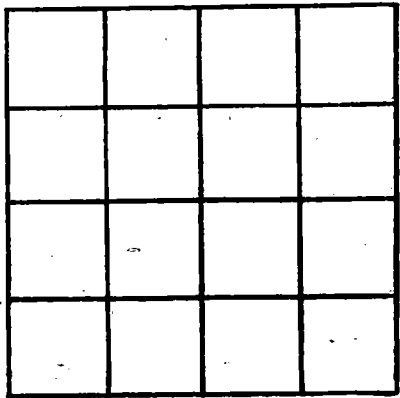

SECTION 20

Please indicate well location X.

ADDITIONAL INFORMATION

Lined area for additional information, consisting of approximately 25 horizontal lines.

If more than one screen, show locations of each on sketch.