

Hancock
K 2210
12-21-75

MISSISSIPPI
 BOARD OF WATER COMMISSIONERS
 416 North State Street
 Jackson, Mississippi 39201
 WATER WELL DRILLERS LOG

12-21- 1975 WARD WELL DLG. HANCOCK
 date well completed firm name county well located

LANDOWNER: ART. BASS
BONITA CIRCLE
BAY ST. LOUIS MISS.
 (mailing address)

WELL LOCATION:
 sec. 22 T 8 N R 14 E
2 miles N/W of B.S.L.
 (distance) (direction) (nearest town)

WELL PURPOSE: HOME
 (home, irrigation, municipal, industrial)

WELL COMPLETION DATA:
 (1) diameter (inches) 2
 (2) total depth (feet) 160
 (3) static water level (feet) 1 ^{below}/_{above} top of ground.
 (4) casing PVC, 155.
 (material) (depth)
 (size) If telescope see back.
 (5) screen 5, -
 (length) (depth to top)
2", PVC
 (size) (material)
 (6) pump 1/2, 8
 (HP) (yield gpm)
Elec.
 (type power)
 (7) electric log NO
 (yes or no)
N/A
 (organization running log)
 (8) how well bottom plugged BWU


description of formations encountered	from	to
Fill - Clay	0	18
sd	18	46
GREY CLAY	46	92
FINE sd.	92	105
BLUE CLAY	105	120
sd - FINE	120	128
BLUE CLAY	128	136
sd	136	160

DRILLERS REMARKS: N/A

RECORDED
 JAN 29 1976
 COMM

If well telescopes please sketch and show depths.

GROUND LEVEL

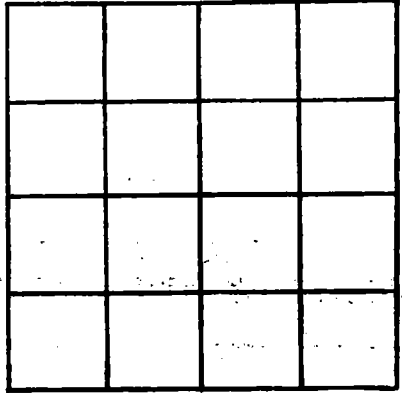

SECTION 22

Please indicate well location X.

ADDITIONAL INFORMATION

If more than one screen, show locations of each on sketch.