

HANCOCK
 K 2212
 1-22-76

MISSISSIPPI
 BOARD OF WATER COMMISSIONERS
 416 North State Street
 Jackson, Mississippi 39201

WATER WELL DRILLERS LOG

1-22-1976 date well completed 76 WARD WELL DRG. firm name HANCOCK county well located


LANDOWNER: PAUL ARTHOFER	description of formations encountered	from	to
Rt. 3, Box 174	Fill - clay	0	41
	SD	41	65
Bay St. Louis, Miss.	GREY CLAY	65	97
(mailing address)	FIRE SD	97	112
WELL LOCATION:	SILT - SD - CLAY	112	260
sec. 22 T 8 N R 14 E	SD	260	265
2 1/2 miles N/W of B.S.L.	CLAY	265	272
(distance) (direction) (nearest town)	SD	272	284
WELL PURPOSE: NONE	CLAY	284	295
(home, irrigation, municipal, industrial)	SD	295	306
WELL COMPLETION DATA:	SILT - CLAY	306	358
(1) diameter (inches) 2"	SD	358	382
(2) total depth (feet) 382			
(3) static water level (feet) 3 below top of ground			
(4) casing PVC 377 (material) (depth)			
(size) If telescope see back.			
(5) screen 5 (length) (depth to top)			
2" PVC (size) (material)			
(6) pump 1/2 (HP) 9 (yield gpm)			
Elec. (type power)			
(7) electric log NO (yes or no)			
N/A (organization funding log)			
(8) how well bottom plugged BWW			

DRILLERS REMARKS: N/A

RECEIVED
 JAN 20 1976

If well telescopes please sketch and show depths.

GROUND LEVEL

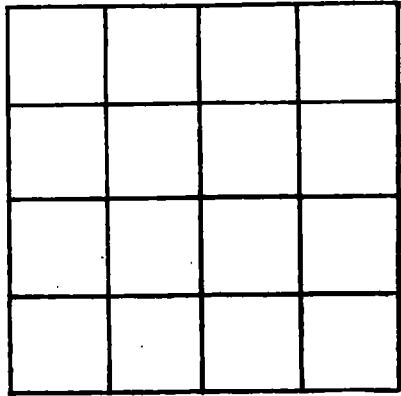

SECTION 22

Please indicate well location X.

ADDITIONAL INFORMATION

If more than one screen, show locations of each on sketch.