

HANCOCK
 K 2213
 3-6-76

MISSISSIPPI
 BOARD OF WATER COMMISSIONERS
 416 North State Street
 Jackson, Mississippi 39201

WATER WELL DRILLERS LOG

March 6 1976 Farewell well Hancock
 date well completed firm name county well located

LANDOWNER: Pat. Strong
Bay Side Park
 (mailing address)

WELL LOCATION:
 sec. 32 T. 8 N. R. 14 E.
5 miles W of B.S.L.
 (distance) (direction) (nearest town)

WELL PURPOSE: Home
 (home, irrigation, municipal, industrial)

- WELL COMPLETION DATA:
- (1) diameter (inches) 2
 - (2) total depth (feet) 130
 - (3) static water level (feet) 12 ^{below}/_{above} top of ground.
 - (4) casing plastic 130
 (material) (depth)
2 If telescope see back.
 (size)
 - (5) screen 10 ft. 130
 (length) (depth to top)
2 plastic
 (size) (material)
 - (6) pump HP 1/2
 (HP) (yield/gpm)
 - (7) electric log (yes or no) no
 - (organization running log)
 - (8) how well bottom plugged B.W.V.


description of formations encountered	from	to
<u>Clay sand</u>	<u>0</u>	<u>10</u>
<u>Clay</u>	<u>10</u>	<u>20</u>
<u>Red sand</u>	<u>20</u>	<u>30</u>
<u>sand clay</u>	<u>30</u>	<u>40</u>
<u>Clay</u>	<u>40</u>	<u>50</u>
<u>Clay</u>	<u>50</u>	<u>60</u>
<u>Clay</u>	<u>60</u>	<u>70</u>
<u>sand</u>	<u>70</u>	<u>80</u>
<u>sand</u>	<u>80</u>	<u>90</u>
<u>Clay sand</u>	<u>90</u>	<u>100</u>
<u>Clay</u>	<u>100</u>	<u>110</u>
<u>Clay</u>	<u>110</u>	<u>120</u>
<u>sand (120 ft)</u>	<u>120</u>	<u>130</u>

RECEIVED
 OCT 2 1978

DRILLERS REMARKS: _____
 MISS. BD. OF WATER COMM

If well telescopes please sketch and show depths.

GROUND LEVEL

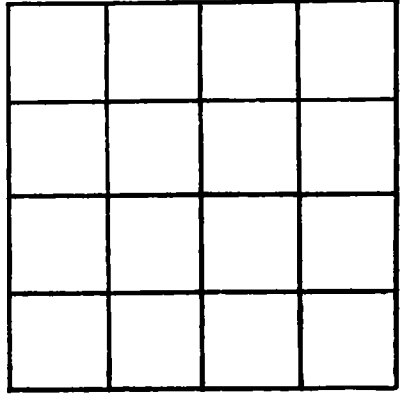

SECTION _____

Please indicate well location X.

ADDITIONAL INFORMATION

If more than one screen, show locations of each on sketch.