

HANCOCK
K 2215
4-12-76

MISSISSIPPI
 BOARD OF WATER COMMISSIONERS
 416 North State Street
 Jackson, Mississippi 39201

WATER WELL DRILLERS LOG

4-12- 1976 Woodwell Dlg. Hancock
 date well completed firm name county well located

LANDOWNER: Maple Hamett
Whisper Bayou Rd.
Prealington, Miss.
 (mailing address)


description of formations encountered	from	to
<u>Top Soil - clay</u>	<u>0</u>	<u>16</u>
<u>Sd</u>	<u>16</u>	<u>36</u>
<u>Grey clay</u>	<u>36</u>	<u>45</u>
<u>Clay Shell</u>	<u>45</u>	<u>96</u>
<u>Sd</u>	<u>96</u>	<u>115</u>

WELL LOCATION:
 sec. 27 T 9 N R 14 E
2.18 miles W of B.S.L.
 (distance) (direction) (nearest town)

WELL PURPOSE: Home
 (home, irrigation, municipal, industrial)


- WELL COMPLETION DATA:
- (1) diameter (inches) 2
 - (2) total depth (feet) 115
 - (3) static water level (feet) 9 ^{below} _{above} top of ground.
 - (4) casing PVC, 110
 (material) (depth)
- if telescope see back.
 (size)
 - (5) screen 5', -
 (length) (depth to top)
2", PVC
 (size) (material)
 - (6) pump OWNERS
 (HP) (yield gpm)
- (type power)
 - (7) electric log NO
 (yes or no)
N/A
 (organization running log)
 - (8) how well bottom plugged BWC

DRILLERS REMARKS: N/A

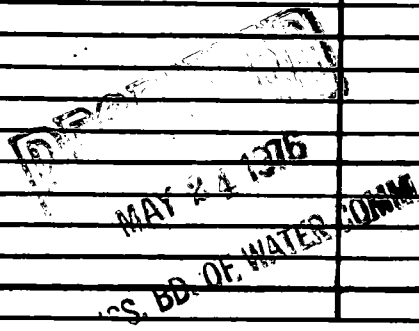

If well telescopes please sketch and show depths.

GROUND LEVEL

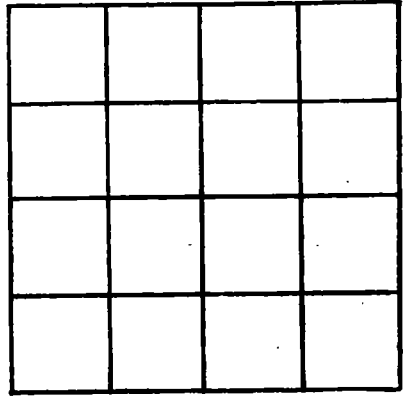

SECTION 35

Please indicate well location X.

ADDITIONAL INFORMATION

A series of horizontal lines providing space for additional information.

If more than one screen, show locations of each on sketch.