

**HANCOCK**  
 K 22-16  
 4-13-76

MISSISSIPPI  
 BOARD OF WATER COMMISSIONERS  
 416 North State Street  
 Jackson, Mississippi 39201

WATER WELL DRILLERS LOG

4-13-76 date well completed      Wood Well Drilling firm name      Hancock county well located

LANDOWNER: Virgil Jackson  
River Side Ave  
Readington, Miss  
 (mailing address)

description of formations encountered	from	to
Sand fill	0	3
clay	3	15
sd	15	34
clay	34	97
sd	97	115


WELL LOCATION:  
~~27~~ sec. ~~28~~ T ~~9~~ N R 14 E  
7.19 miles W of B.S.L.  
 (distance) (direction) (nearest town)

WELL PURPOSE: Home  
 (home, irrigation, municipal, industrial)

WELL COMPLETION DATA:

- (1) diameter (inches) 2
- (2) total depth (feet) 115
- (3) static water level (feet) 4 <sup>below</sup> above top of ground.
- (4) casing PVC 110  
 (material) (depth)  
 (size) If telescope see back.
- (5) screen 5'  
 (length) (depth to top)  
2" PVC  
 (size) (material)
- (6) pump 1/2 9  
 (HP) (yield gpm)  
elec.  
 (type power)
- (7) electric log NO  
 (yes or no)  
N/A  
 (organization running log)
- (8) how well bottom plugged BWU

DRILLERS REMARKS: N/A

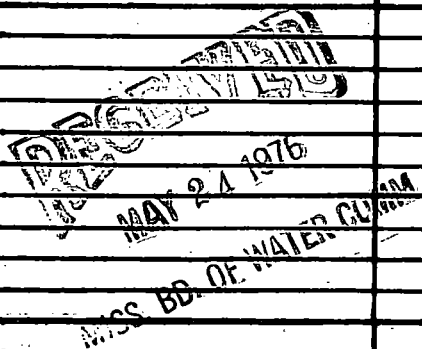

If well telescopes please sketch and show depths.

GROUND LEVEL


SECTION 28

Please indicate well location X.

ADDITIONAL INFORMATION

If more than one screen, show locations of each on sketch.