

HANCOCK
K 2817
4-17-76

MISSISSIPPI
 BOARD OF WATER COMMISSIONERS
 416 North State Street
 Jackson, Mississippi 39201

WATER WELL DRILLERS LOG

41-17- 19 76 ward well Dlg. Hancock
 date well completed firm name county well located

LANDOWNER: Juliette Dean
First & Logan
Bay St. Louis, miss
 (mailing address)

description of formations encountered	from	to
clay	0	18
sd	18	26
clay	26	94
Fine sd	94	110
Blue clay	110	135
sd	135	165

WELL LOCATION:
 sec. 40 T. 8 N R. 14 E
6 miles N/W of B.S.L.
 (distance) (direction) (nearest town)

WELL PURPOSE: Home
 (home, irrigation, municipal, industrial)

- WELL COMPLETION DATA:
- (1) diameter (inches) 2"
 - (2) total depth (feet) 165
 - (3) static water level (feet) 5 calog above top of ground.
 - (4) casing PVC
 (material) (depth)
 - If telescope see back.
 (size)
 - (5) screen 5'
 (length) (depth to top)
 - 2" PVC
 (size) (material)
 - (6) pump owner
 (HP) (yield gpm)
 - (type power)
 - (7) electric log no
 (yes or no)
 - N/A
 (organization running log)
 - (8) how well bottom plugged BWU


DRILLERS REMARKS: N/A

MAY 22 1976

MISS. BD. OF WATER COMM

If well telescopes please sketch and show depths.

GROUND LEVEL

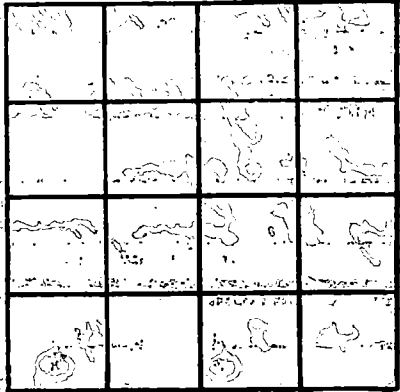

SECTION 40

Please indicate well location X.

ADDITIONAL INFORMATION

If more than one screen, show locations of each on sketch.