

HANCOCK  
K 2919  
8/31/76

MISSISSIPPI  
 BOARD OF WATER COMMISSIONERS  
 416 North State Street  
 Jackson, Mississippi 39201

WATER WELL DRILLERS LOG

8-31 1976 Recovery Drills Hancock  
 date well completed firm name county well located

LANDOWNER: Mr. Stacy Knox  
Gretna Heating and Air Conditioning  
Autree - La.  
 (mailing address)

description of formations encountered	from	to
Clay - Stumps -	0	14
Sd - White Heavy -	14	40
Sd - Shell Blue Bumbo	40	76
Slt - Blue Shale	76	96
Sd - Fair to Good -	96	150

WELL LOCATION:  
 sec 20 T 8 N R 14 E  
4 miles N of Bay St. Louis  
 (distance) (direction) (nearest town)

WELL PURPOSE: home comp  
 (home, irrigation, municipal, industrial)


- WELL COMPLETION DATA:
- (1) diameter (inches) 2
  - (2) total depth (feet) 150'
  - (3) static water level (feet) 2' <sup>below</sup> <sub>above</sub> top of ground.
  - (4) casing PVC 150'  
 (material) (depth)  
2" If telescope see back.  
 (size)
  - (5) screen 5' 145'  
 (length) (depth to top)  
2" PVC WRAP  
 (size) (material)
  - (6) pump 1/2 9  
 (HP) (yield gpm)  
115 V  
 (type power)
  - (7) electric log —  
 (yes or no)  
 (organization running log)
  - (8) how well bottom plugged sealed

DRILLERS REMARKS: good  
Recovery - 2 gpm - convert  
able - on 30 gal tank.

**RECEIVED**  
 SEP 15 1976  
 MISS. BD. OF WATER COMMISSIONERS

If well telescopes please sketch and show depths.

GROUND LEVEL

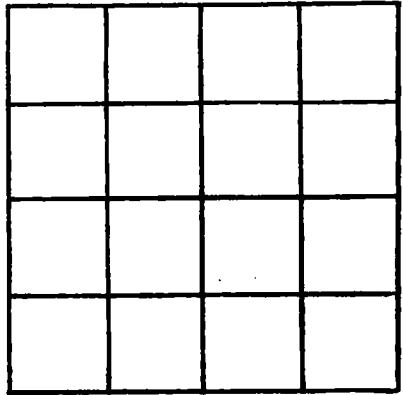

SECTION \_\_\_\_\_

Please indicate well location X.

ADDITIONAL INFORMATION

If more than one screen, show locations of each on sketch.