

Hancock
 R 2220
 8/26/76

MISSISSIPPI
 BOARD OF WATER COMMISSIONERS
 416 North State Street
 Jackson, Mississippi 39201

WATER WELL DRILLERS LOG

8-26 1976 Pauceny Driller Hancock
 date well completed firm name county well located

LANDOWNER: MR. CARROLL
 LAcomb - LA-
 (mailing address)
 WELL LOCATION:
 sec 27 T 8 N R 14 E S W
 3 miles N of Bay St. Louis
 (distance) (direction) (nearest town)

description of formations encountered	from	to
Sd - Snafree	0	40
Blue clay shaly -	40	68
Shale Blue - Sd.	68	76
Blue Clay	76	90
Clay shaly -	90	120
Sd -	120	187
Slt. Clay Sd.	187	190
Sd - Sd R to Better.	190	208

WELL PURPOSE: home camp
 (home, irrigation, municipal, industrial)

WELL COMPLETION DATA:
 (1) diameter (inches) 2
 (2) total depth (feet) 208
 (3) static water level (feet) 6' below top of ground
 (4) casing PVC to 196 (material) (depth)
 2" (size) if telescope see back.
 (5) screen 10' 196 (length) (depth to top)
 2" PVC WRAP (size) (material)
 (6) pump ? (HP) ? (yield gpm)
 ? (type power)
 (7) electric log (yes or no)
 (organization running log)
 (8) how well bottom plugged sealed


DRILLERS REMARKS: Owned
 used his pump

RECEIVED
 SEP 15 1976

MISS. BD. OF WATER COMM.

If well telescopes please sketch and show depths.

GROUND LEVEL

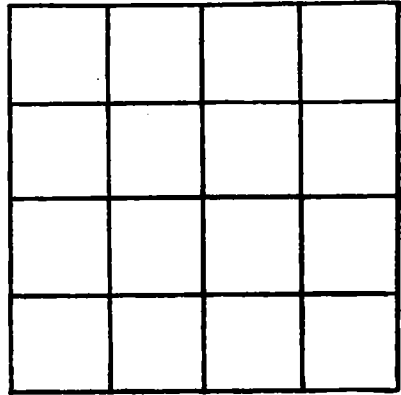

SECTION _____

Please indicate well location X.

ADDITIONAL INFORMATION

If more than one screen, show locations of each on sketch.