

Hancock
~~1976~~
R 2224
9-10-76

MISSISSIPPI
 BOARD OF WATER COMMISSIONERS
 416 North State Street
 135 Jackson, Mississippi 39201

WATER WELL DRILLERS LOG

9-10 1976 Ward Well Dlg. Hancock
 date well completed firm name county well located

LANDOWNER James Forbit
Wolf St.
Bay St. Louis miss
 (mailing address)

description of formations encountered	from	to
<u>fill - clay</u>	<u>0</u>	<u>20</u>
<u>clay - shell</u>	<u>20</u>	<u>46</u>
<u>sd</u>	<u>46</u>	<u>97</u>
<u>sc</u>	<u>97</u>	<u>115</u>
<u>Red gravel - sd</u>	<u>115</u>	<u>165</u>
<u>clay - silt</u>	<u>165</u>	<u>490</u>
<u>sd</u>	<u>490</u>	<u>530</u>

WELL LOCATION:
 sec. 37 T. 8 N R. 14 E
1 miles N of B.S.L.
 (distance) (direction) (nearest town)

WELL PURPOSE: Home
 (home, irrigation, municipal, industrial)

- WELL COMPLETION DATA:
- (1) diameter (inches) 2"
 - (2) total depth (feet) 530 ft.
 - (3) static water level (feet) 5 below top of ground. (above)
 - (4) casing PVC, 520,
 (material) (depth)
 (size) If telescope see back.
 - (5) screen 10',
 (length) (depth to top)
2", PVC
 (size) (material)
 - (6) pump Ornu
 (HP) (yield gpm)
 (type power)
 - (7) electric log NO
 (yes or no)
N/A
 (organization running log)
 - (8) how well bottom plugged BWU


DRILLERS REMARKS: N/A

RECEIVED
 OCT 14 1976

MISS. BD. OF WATER COMMISSIONERS

If well telescopes please sketch and show depths.

GROUND LEVEL

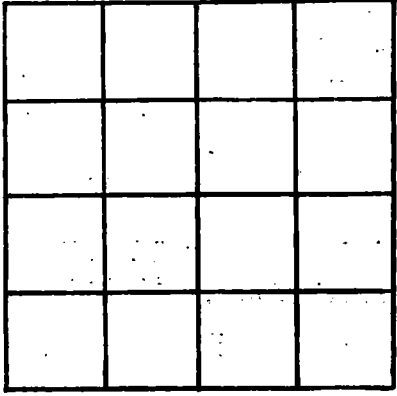

SECTION 37

Please indicate well location X.

ADDITIONAL INFORMATION

A series of horizontal lines providing space for additional information.

If more than one screen, show locations of each on sketch.