

HANCOCK
K 2225
9-14-76

MISSISSIPPI
 BOARD OF WATER COMMISSIONERS
 416 North State Street
 Jackson, Mississippi 39201

WATER WELL DRILLERS LOG

9-14
 date well completed

¹³⁰1976 Wardwell Drilling
 firm name

Hancock
 county well located

LANDOWNER: W. Justice
Bay Side Park
Bay St. Louis, Miss.
 (mailing address)

description of formations encountered	from	to
	top Soil - clay	0
sd	15	38
clay - shell	38	96
sd	96	117
clay	117	131
Red Shovel - sd	131	166

WELL LOCATION:
 sec 6 T 9 N R 14 E
7 miles W of B.S.L.
 (distance) (direction) (nearest town)

WELL PURPOSE: Home
 (home, irrigation, municipal, industrial)

- WELL COMPLETION DATA:
- (1) diameter (inches) 2"
 - (2) total depth (feet) 160'
 - (3) static water level (feet) 7 ^{below} _{above} top of ground.
 - (4) casing PVC, 155'
 (material) (depth)
 (size) If telescope see back.
 - (5) screen 2', -
 (length) (depth to top)
2", PVC
 (size) (material)
 - (6) pump none
 (HP) (yield gpm)
 (type power)
 - (7) electric log no
 (yes or no)
 (organization running log)
 - (8) how well bottom plugged B.W.V.


DRILLERS REMARKS: W/n

RECEIVED

OCT 14 1976

If well telescopes please sketch and show depths.

GROUND LEVEL

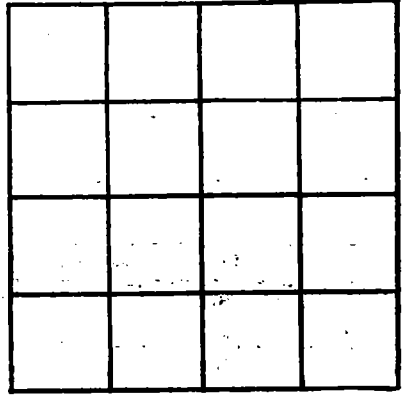

SECTION 6

Please indicate well location X.

ADDITIONAL INFORMATION

A series of horizontal lines for providing additional information.

If more than one screen, show locations of each on sketch.