

Hancock
K 2998
10-12-76

MISSISSIPPI
 BOARD OF WATER COMMISSIONERS
 416 North State Street
 Jackson, Mississippi 39201

WATER WELL DRILLERS LOG

10-12 1976 Ward Well Drilling Hancock
 date well completed firm name county well located

LANDOWNER: Louis Foret
Klein Sude.
Bay St. Louis, Miss.
 (mailing address)

WELL LOCATION:
 sec. 7 T. 9 N R. 14 E
7 miles S/W of B.S. Lake
 (distance) (direction) (nearest town)

WELL PURPOSE: Home
 (home, irrigation, municipal, industrial)

- WELL COMPLETION DATA:
- (1) diameter (inches) 2"
 - (2) total depth (feet) 315
 - (3) static water level (feet) 9 ^{below} _{above} top of ground.
 - (4) casing PVC, 305,
 (material) (depth)
 (size) if telescope see back.
 - (5) screen 10', -
 (length) (depth to top)
2", PVC
 (size) (material)
 - (6) pump 1/2, 9
 (HP) (yield gpm)
etc.
 (type power)
 - (7) electric log NO
 (yes or no)
N/A
 (organization running log)
 - (8) how well bottom plugged BWV

description of formations encountered	from to	
<u>Top Soil - clay</u>	<u>0</u>	<u>17</u>
<u>sd</u>	<u>17</u>	<u>37</u>
<u>Argy clay - Shell</u>	<u>37</u>	<u>96</u>
<u>Arg. Shale - sd</u>	<u>96</u>	<u>118</u>
<u>Clay Silt</u>	<u>118</u>	<u>216</u>
<u>fs. sh. sd</u>	<u>216</u>	<u>221</u>
<u>clay - silt</u>	<u>221</u>	<u>296</u>
<u>sd - coarse</u>	<u>296</u>	<u>315</u>

DRILLERS REMARKS: N/A


RECEIVED

NOV 29 1976

MISS. BD. OF WATER COMMISSIONERS

If well telescopes please sketch and show depths.

GROUND LEVEL

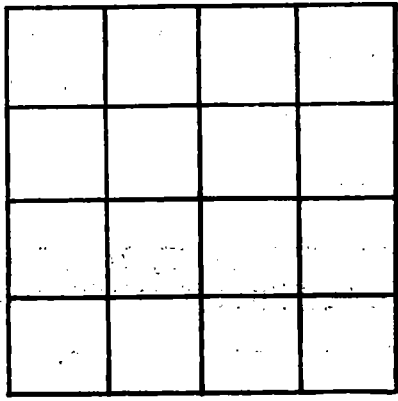

SECTION 7

Please indicate well location X.

ADDITIONAL INFORMATION

A series of horizontal lines providing space for additional information or notes.

If more than one screen, show locations of each on sketch.