

HANCOCK
K. 2229
10-13-76

MISSISSIPPI
BOARD OF WATER COMMISSIONERS
416 North State Street
Jackson, Mississippi 39201

WATER WELL DRILLERS LOG

10-13-1976 date well completed Ward Well Drilling firm name Hancock county well located

LANDOWNER: Frank Klein Jr.
Klein Drick.
Bay St. Louis, Miss.
(mailing address)

WELL LOCATION:
sec. 7 T. 9 N. R. 14 E.
7 miles S/W of B.S.L.
(distance) (direction) (nearest town)

WELL PURPOSE: Home
(home, irrigation, municipal, industrial)

- WELL COMPLETION DATA:
- (1) diameter (inches) 2"
 - (2) total depth (feet) 316
 - (3) static water level (feet) 9 ^{below} ~~above~~ top of ground.
 - (4) casing PVC (material), 311 (depth)
2" (size) If telescope see back.
 - (5) screen 5' (length), - (depth to top)
2" (size), PVC (material)
 - (6) pump 1/2 (HP), 9 (yield gpm)
Elec. (type power)
 - (7) electric log NO (yes or no)
N/A (organization running log)
 - (8) how well bottom plugged 90%

description of formations encountered	from	to
top soil - clay	0	18
sd	18	37
dry clay - shell	37	95
Red gravel - sd	95	117
Clay - silt	117	216
Fine sd	216	221
Clay	221	225
sd - coarse	225	316

RECEIVED


NOV 29 1976

DRILLERS REMARKS: N/A

MISS. BD. OF WATER COMM

If well telescopes please sketch and show depths.

GROUND LEVEL

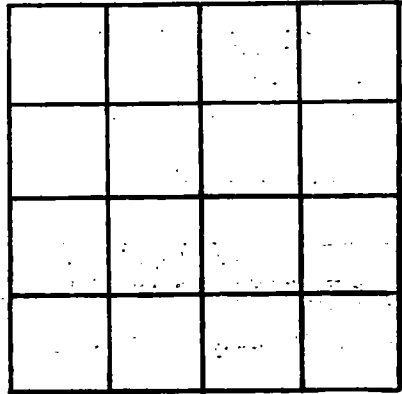

SECTION 2

Please indicate well location X.

ADDITIONAL INFORMATION

If more than one screen, show locations of each on sketch.