

Hancock
K 2230
10-15-76

MISSISSIPPI
 BOARD OF WATER COMMISSIONERS
 416 North State Street
 Jackson, Mississippi 39201

WATER WELL DRILLERS LOG

10-15-76 19 Woodwell Drilling Hancock
 date well completed firm name county well located

LANDOWNER: Thomas Albrock
Rt. 3, Box 425
Bay St. Louis, Miss.
 (mailing address)

description of formations encountered	from	to
Top Soil - SD	0	15
SD	15	47
Heavy Clay - shell	47	106
Platy Shell - SD	106	177
Clay - Silt	177	395
SD Course	395	450

WELL LOCATION:
 sec. 34 T. 8 N R. 14 E
5 miles W of B.S.L.
 (distance) (direction) (nearest town)

WELL PURPOSE: Home
 (home, irrigation, municipal, industrial)

WELL COMPLETION DATA:

(1) diameter (inches) 2"

(2) total depth (feet) 450

(3) static water level (feet) 2 ^{Below} top of ground

(4) casing PVC, 435,
 (material) (depth)

- If telescope see back.
 (size)

(5) screen 15', -
 (length) (depth to top)

2", PVC
 (size) (material)

(6) pump owner, -
 (HP) (yield gpm)

-
 (type power)

(7) electric log NO
 (yes or no)

N/A
 (organization running log)

(8) how well bottom plugged B.W.

DRILLERS REMARKS: Drilled to
639 feet. Fine sd. - 25'
at 540 - 565 feet - Set
Casing at 450.


RECEIVED

NOV 29 1976

MISS. BD. OF WATER COMMISSIONERS

If well telescopes please sketch and show depths.

GROUND LEVEL

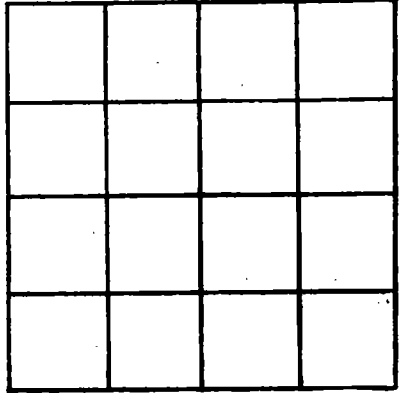

SECTION 34

Please indicate well location X.

ADDITIONAL INFORMATION

If more than one screen, show locations of each on sketch.