

Hancock
K 2231
10-17-76

MISSISSIPPI
BOARD OF WATER COMMISSIONERS
416 North State Street
Jackson, Mississippi 39201

WATER WELL DRILLERS LOG

10-17 1976 Wood Well Drilling Hancock
date well completed firm name county well located

LANDOWNER	description of formations encountered	from	to
Holly St. - Klein Sides	Top Soil - clay	0	17
Bay St. Spine, Miss	SP	17	35
(mailing address)	Grey Clay - Shell	35	96
	Clay - Shell - fine sand	96	118
	Clay - Shell	118	209
	SP - Fine	209	217
	Clay - Shell	217	226
	SP - Coarse	226	310

WELL LOCATION:
sec. 2 T 9 N R 14 E
7 miles S/W of B.S.L.
(distance) (direction) (nearest town)

WELL PURPOSE: Home
(home, irrigation, municipal, industrial)

- WELL COMPLETION DATA:
- (1) diameter (inches) 2"
 - (2) total depth (feet) 310'
 - (3) static water level (feet) 9 (below/above top of ground)
 - (4) casing PVC, 300' (material), (depth)
2" (size) if telescope see back.
 - (5) screen 10' (length), (depth to top)
2" (size), PVC (material)
 - (6) pump 1/2 HP, 9 (yield gpm)
Etc. (type power)
 - (7) electric log ~~NO~~ (yes or no)
N/A (organization running log)
 - (8) how well bottom plugged BWV

DRILLERS REMARKS: N/A


RECEIVED

NOV 29 1976

COMM.

If well telescopes please sketch and show depths.

GROUND LEVEL

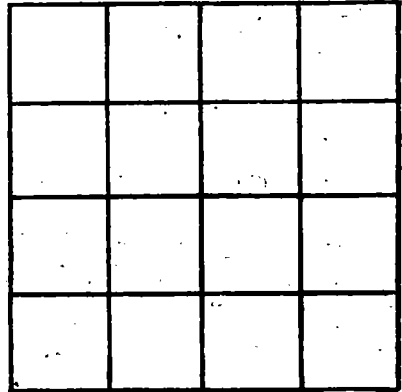

SECTION 7

Please indicate well location X.

ADDITIONAL INFORMATION

If more than one screen, show locations of each on sketch.