

Hancock
 K 2232
 10-20-76

MISSISSIPPI
 BOARD OF WATER COMMISSIONERS
 416 North State Street
 Jackson, Mississippi 39201

WATER WELL DRILLERS LOG

10-20 1976 Woodwell Drilling Hancock
 date well completed firm name county well located

LANDOWNER: R. J. Renton
 Garden Lake Subd.
 Bay St. Louis, Miss.
 (mailing address)

description of formations encountered	from	to
clay	0	25
sd	25	32
clay-silt	32	265
fine sd	267	301
clay silt	301	382
sd-concrete	382	415

WELL LOCATION:
 sec 27 T 8 N R 14 E
 4 miles N/W of B.S.L.
 (distance) (direction) (nearest town)

WELL PURPOSE: Home
 (home, irrigation, municipal, industrial)

- WELL COMPLETION DATA:
- (1) diameter (inches) 2"
 - (2) total depth (feet) 415'
 - (3) static water level (feet) 1' below top of ground
 - (4) casing PVC, 405' (material) (depth)
 - (size) if telescope see back.
 - (5) screen 10' (length) (depth to top)
 - 2" PVC (size) (material)
 - (6) pump owner (HP) (yield gpm)
 - (type power)
 - (7) electric log NO (yes or no)
 - N/A (organization running log)
 - (8) how well bottom plugged BWD


DRILLERS REMARKS: N/A

RECEIVED

NOV 29 1976

If well telescopes please sketch and show depths.

GROUND LEVEL

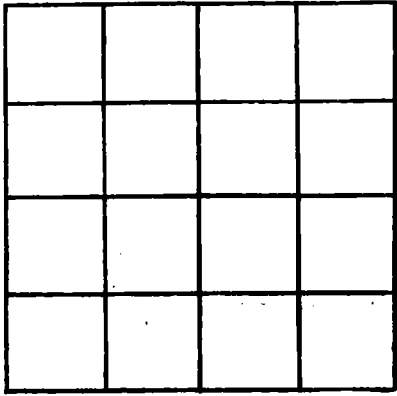

SECTION 22

Please indicate well location X.

ADDITIONAL INFORMATION

Lined area for additional information, consisting of approximately 20 horizontal lines.

If more than one screen, show locations of each on sketch.