

HANCOCK
K 2239
6-20-77

MISSISSIPPI
 BOARD OF WATER COMMISSIONERS
 416 North State Street
 Jackson, Mississippi 39201

WATER WELL DRILLERS LOG

6-20- 1977 Woodwell Drilling Hancock
 date well completed firm name county well located

LANDOWNER: Bernard Lemoine
First St.
Bay St. Louis Miss.
 (mailing address)

description of formations encountered	from	to
<u>top Soil-clay</u>	<u>0</u>	<u>16</u>
<u>SC</u>	<u>16</u>	<u>45</u>
<u>clay</u>	<u>45</u>	<u>97</u>
<u>Zone of</u>	<u>97</u>	<u>115</u>
<u>Clay Silt</u>	<u>115</u>	<u>186</u>
<u>SD.</u>	<u>186</u>	<u>215</u>

WELL LOCATION:
 sec. 28 T. 9 N. R. 14 E.
7 miles N/W of B.S.L.
 (distance) (direction) (nearest town)

WELL PURPOSE: None
 (home, irrigation, municipal, industrial)

- WELL COMPLETION DATA:
- (1) diameter (inches) 2"
 - (2) total depth (feet) 215
 - (3) static water level (feet) 4 ^(below) above top of ground.
 - (4) casing PVC, 210.
 (material) (depth)
 (size) If telescope see back.
 - (5) screen 5', -
 (length) (depth to top)
2", PVC
 (size) (material)
 - (6) pump none, -
 (HP) (yield gpm)
 (type power)
 - (7) electric log no
 (yes or no)
N/A
 (organization running log)
 - (8) how well bottom plugged BWU

DRILLERS REMARKS: -


RECEIVED

JUL 20 1977

MISS. BD. OF WATER COMM

If well telescopes please sketch and show depths.

GROUND LEVEL

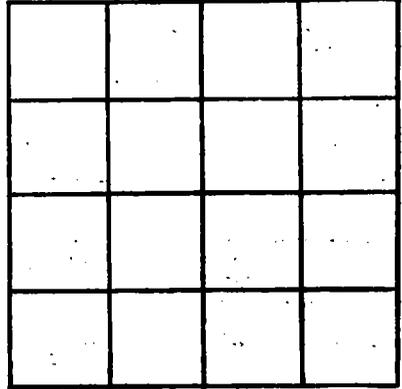

SECTION _____

Please indicate well location X.

ADDITIONAL INFORMATION

If more than one screen, show locations of each on sketch.