

HANCOCK  
K 2741  
10-6-77

MISSISSIPPI  
BOARD OF WATER COMMISSIONERS  
416 North State Street  
135 Jackson, Mississippi 39201

WATER WELL DRILLERS LOG

10-6-1977 date well completed      Ward Well Drg firm name      Hancock county well located

LANDOWNER: Ray Jones  
Bay Side Park  
Bay St. Louis miss  
(mailing address)

WELL LOCATION:  
sec 6 T 8 N R 14 E  
8 miles W of B.S.L.  
(distance) (direction) (nearest town)

WELL PURPOSE: Home  
(home, irrigation, municipal, industrial)

WELL COMPLETION DATA:

(1) diameter (inches) 2"

(2) total depth (feet) 165

(3) static water level (feet) 9 below above top of ground.

(4) casing PVC 160  
(material) (depth)

- If telescope see back.  
(size)

(5) screen 5' -  
(length) (depth to top)

2" PVC  
(size) (material)

(6) pump 1/2 10  
(HP) (yield gpm)

Elc.  
(type power)

(7) electric log no  
(yes or no)

N/A  
(organization running log)

(8) how well bottom plugged BWW

description of formations encountered	from	to
Top Soil - clay	0	18
SD	18	35
clay	35	60
clay - shell	60	87
clay - silt	87	138
Red gravel - SD	138	166


RECEIVED  
NOV 16 1977

MISS. BD. OF WATER COMMISSIONERS

DRILLERS REMARKS:

If well telescopes please sketch and show depths.

GROUND LEVEL

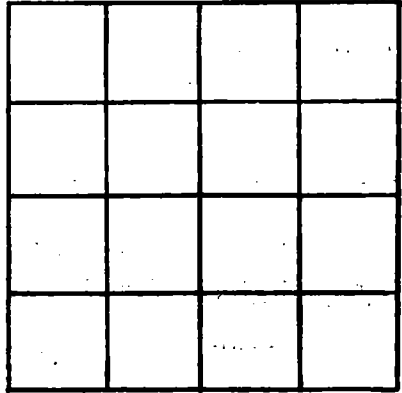

SECTION 6

Please indicate well location X.

ADDITIONAL INFORMATION

If more than one screen, show locations of each on sketch.